

Section 30 Township 20 Range 11W

Well No. #5 Jutting

Company Bay Petroleum

NORTH

WEST

EAST

SOUTH

Barton

KANSAS
11 W

Sec. 30 Twp. 20 R. 11 W

Well No. # 5 Jutting Farm

Bay Petroleum Company

Lewis Contractor

Kowlsky


990 Ft. from N. Line

_____ Ft. from S. Line

330 Ft. from E. Line

_____ Ft. from W. Line

SE NE SE

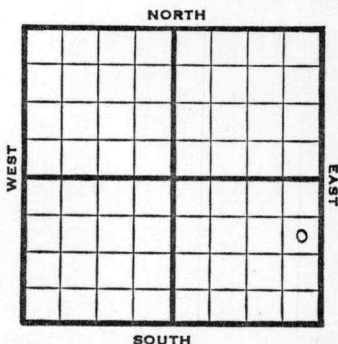


1951 Elev. 1809' REPORT

10/17 Spud 10-13-51
8" @ 576
Drlg. 1995'

10/24 Spud 10-13-51
D&A TD 3400
8" @ 576
Heeb. 2978 Br. 1m. 3114
Ians. 3127
DST 3252-61 open 45 min.
Rec. 12' SOCM
Cong. 3357 Arb. 3385
DST 3389-3400 open 45 min.
Rec. 127' SW
TD 3400
D&A

ABANDONED

J. E. TYRA

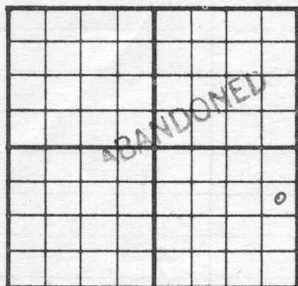County Barton State KansasSec. 30- (Blk.
Twp.) 20 (Sur.
Rge.) 11W Map No.Operator Bay PetroleumWell No. 5 Farm JuttingElev. 1809 Location SE NE SE990 Ft. From N Line SE330 Ft. From E Line Quarter

1st. Report

Completion OCT 24 1951Remarks Kowalsky PoolLewis - Contr.Spudding Date 10-13-51Drlg. Data D & A TD 34008" @ 576 Heeb. 2978 Br. lime 3114Lans. 3127 DST 3252-61 open 45 min.Rec. 12' socm Cong. 3357 Arb. 3385DST 3389-3400 open 45 min. Rec. 127' swTD 3400 D & A

J. E. TYRA