


Section 5 Township 18 Range 10-W

Well No. #11 Habiger

Company Mission Oil Corp.

NORTH **Bloomer Pool**

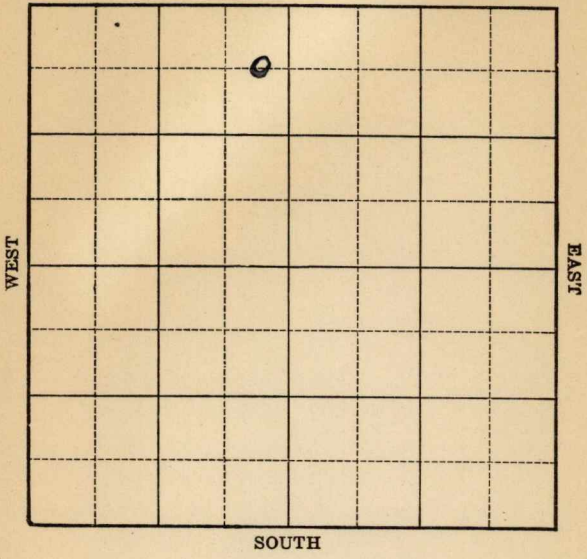

**KANSAS**

Rice

Sec. 5 Twp. 18 R. 10-W

Well No. #11 Habiger Farm

Mission Oil Company

(Bloomer)


660 Ft. from N. Line

\_\_\_\_\_ Ft. from S. Line

330 Ft. from E. Line

\_\_\_\_\_ Ft. from W. Line

**Elev. 1769**

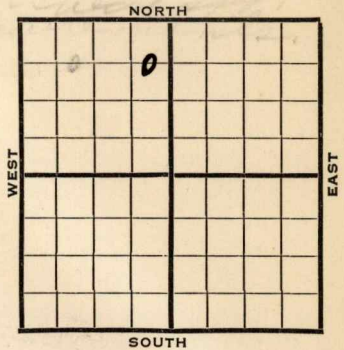

1940	REPORT
6/5	Drlg. 35'
6/13	8" - 198' Drlg. 2069'
6/20	Arb. <del>3228</del> <sup>3226</sup> -30' T.D. 5" - <del>3228 1/2</del> <sup>3226 1/2</sup> '
6/26	Arb. 3226' (Corrected)
	XX 5" - 3226 1/2'
	At 333 1/2' - 1600' oil 4 hours.
	600 acid & 1200 acid at 3234' TD
	1500 acid.
	Pump 304 bbls. 16 hours.
7/2	Arb. 3226'
	5" - 3226 1/2'
	T.D. 3234'
	3200 acid.
	Echometer potential 2129 bbls.
	<b>COMPLETED</b>

Map No. 55 Sec. 5 Twp. 18 R. 10W

Well No. 11 Habiger

Mission Oil Corp. Company

**FIRST REPORT**

Contractor

**SECTION PLAT**

C E L N E N W

660 Ft. from N. Line

\_\_\_\_\_ Ft. from S. Line

330 Ft. from E. Line

\_\_\_\_\_ Ft. from W. Line

BLOOMER POOL

	o		

Location \_\_\_\_\_

Rig up \_\_\_\_\_

Drilling and Remarks:

Drlg. 35'

**RECORD**

Cased \_\_\_\_\_ in., \_\_\_\_\_ ft.

Sand \_\_\_\_\_

Gas \_\_\_\_\_

Oil \_\_\_\_\_

Total Depth \_\_\_\_\_

**PRODUCTION**

1st 24 hrs. Nat. \_\_\_\_\_

1st 24 hrs. after shot \_\_\_\_\_

Gas \_\_\_\_\_ Cu. Ft.

Dry Hole \_\_\_\_\_

Abandoned \_\_\_\_\_

Date

JUN 7 1940

S. J. LEWIS

Scout

Map No. 55 Sec. 5 Twp. 18 R. 10W

Well No. 11 Habiger

Mission Oil Company

Contractor

COMPLETED

SECTION PLAT

C E L N E N W


660 Ft. from N. Line

\_\_\_\_\_ Ft. from S. Line

330 Ft. from E. Line

\_\_\_\_\_ Ft. from W. Line

BLOOMER POOL

Location \_\_\_\_\_

Rig up \_\_\_\_\_

Drilling and Remarks:

*Art 3226*  
*5" C 3226 1/2*  
*3200 acid*  
*Echometer Rt.*  
*2129*

RECORD

Cased \_\_\_\_\_ in., \_\_\_\_\_ ft.

Sand \_\_\_\_\_

Gas \_\_\_\_\_

Oil \_\_\_\_\_

Total Depth 3234

PRODUCTION

1st 24 hrs. Nat. \_\_\_\_\_

1st 24 hrs. after shot \_\_\_\_\_

Gas \_\_\_\_\_ Cu. Ft.

Dry Hole \_\_\_\_\_

Abandoned \_\_\_\_\_

Date

JUL 2 1940 19

S. J. LEWIS  
Scout