


Section 29 Township 20 Range 11W

Well No. #2 Sessler

Company Bay Petroleum

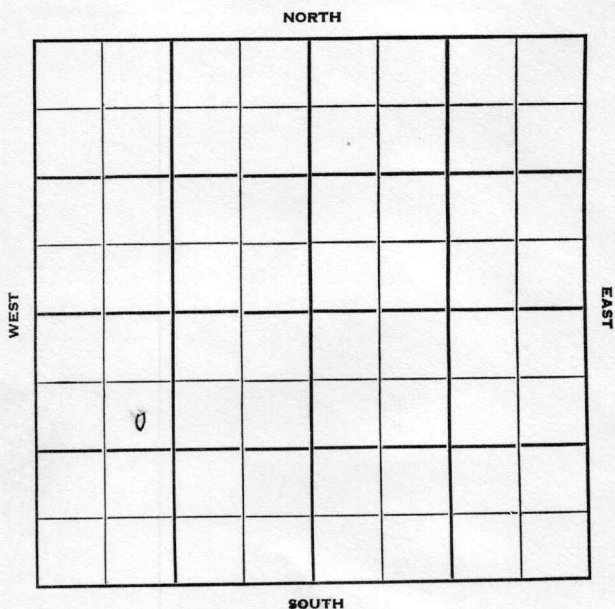

Barton

KANSAS

Sec. 29 Twp. 20 R. 11W ✓

Well No. #2 Sessler Farm

Bay Petroleum Company

Lewis Contractor

Kowalsky


990 Ft. from N. Line

\_\_\_\_\_ Ft. from S. Line

\_\_\_\_\_ Ft. from E. Line

990 Ft. from W. Line

SE NW SW

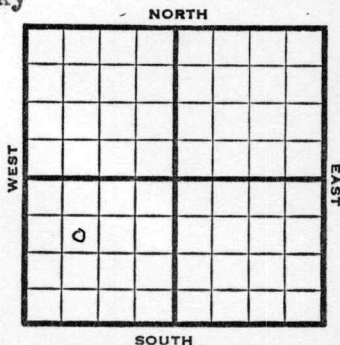

1951

Elev. 1810' REPORT

10/31

Spud 10-26-51  
8" @ 578'  
Drlg. 1840'

1952  
1/2

Spud 10-26-51 Oil well TD 3375'  
8" @ 578' Lans. 3107' Arb. 3355'  
TD 3360' 5" @ 3358' DD 3367'  
DD 3372' 1 GOPH 500 A DD 3375'  
1½ BOPH S/7 BOPH 17 hr.  
Comp. 104 BOPD

COMPLETED

County **Barton** State **Kansas**  
 Sec. **29** (Blk. Twp.) **20** (Sur. Rge.) **11W** Map No.  
 Operator **Bay Petroleum**  
 Well No. **2** Farm **Sessler**  
 Elev. Location **SE NW SW**



**990** Ft. From **N** Line **SW**  
**990** Ft. From **W** Line Quarter

Ist. Report **OCT 31 1951**

Completion

Remarks

**Lewis - Contr.**

Spudding Date **10-26-51**

Drlg. Data **Kowalsky**

**8" @ 578' Drlg. 1840**

**J. E. TYRA**

County Barton State Kansas

Sec. 29 (Blk. Twp.) 20 (Sur. Rge.) 11W Map No.

Operator Bay Petroleum

Well No. 2 Farm Sessler

|       |      |          |          |
|-------|------|----------|----------|
| Elev. | 1810 | Location | SE NW SW |
|-------|------|----------|----------|

990 Ft. From N Line SW

990 Ft. From W Line Quarter

1st. Report

Completion JAN 2 1952

Remarks Kowalsky Pool

Lewis - Contr.

Spudding Date 10-26-51

Drlg. Data      Oil well      TD 3375

8" @ 578      Lans. 3107      Arb. 3355      TD 3360

5" @ 3358 DD 3367 DD 3372 1 goph

500 A DD 3375  $1\frac{1}{2}$  boph S/ 7 boph 17 hr.

Comp. 104 bopd

J. E. TYRA