

KANAS

Barton

Section 30 Township 20 Range 11W

Well No. 1 Soeken

Company Aledo Oil

Kowlaskey

NORTH

0							

WEST

EAST

SOUTH

KANSAS

Barton

Sec. 30 Twp. 20 R. 11W

Well No. #1 Soeken Farm

Aledo Oil

Company

Kowlaskey (Transit Drlg., Cont.)
Pool


 Ft. from N. Line

330' Ft. from S. Line

 Ft. from E. Line

330' Ft. from W. Line

SW NW

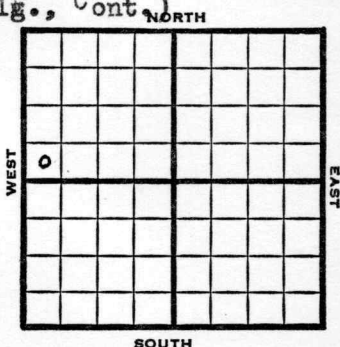

1949

Elev 1817'

REPORT

6/22

8" @ 315'

Drlg. 1654'

6/28

Lansing 3144'

Arb. 3381-

TD 3387'

5 @ 3383'

7/6

1000 acid

7/13

TD 3403'

Arb. 3381'

5 @ 3383'

Aband.

ABANDONED

Map No. _____ Sec. 30 Twp. 20 R. 11W

Well No. 1 Soeken

Aledo Oil

Company

Transit

Contractor

SW NW


FIRST REPORT
SECTION PLAT

_____ Ft. from N. Line

330 Ft. from S. Line

_____ Ft. from E. Line

330 Ft. from W. Line

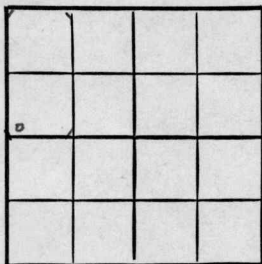

Barton County

Location _____

Rig up _____

Drilling and Remarks:

8" @ 315

drlg. 1654

RECORD

Cased _____ in., _____ ft.

Sand _____

Gas _____

Oil _____

Total Depth _____

PRODUCTION

1st 24 hrs. Nat. _____

1st 24 hrs. after shot _____

Gas _____ Cu. Ft.

Dry Hole _____

Abandoned _____

Date

JUN 22 1949

19

S. J. LEWIS

Scout

Kansas

Kowalsky Pool

Map No. K46 Sec. 30 Twp. 20 R. 11WWell No. 1 SoekenAlado Oil

Company

ABANDONED

Contractor

SW NW

E11877
SECTION PLAT

6			

 Ft. from N. Line330 Ft. from S. Line Ft. from E. Line330 Ft. from W. Line

Barton County

Location Rig up

Drilling and Remarks:

*cu 3387**5" C3383***RECORD**Cased in., ft.Sand Gas Oil Total Depth 3403**PRODUCTION**1st 24 hrs. Nat. 1st 24 hrs. after shot Gas Cu. Ft.Dry Hole Abandoned

Date

JUL 13 1949S. J. LEWIS

Scout