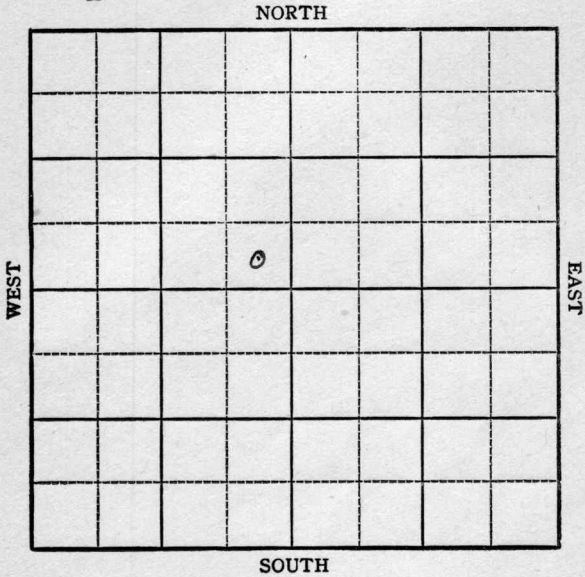


Section 30 Township 20 Range 11-WWell No. #1 Soeken "B"Company R L Williams
Kowalsky

Sec. 30 Twp. 20 R. 11-W ✓

Well No. #1 Soeken "B" Farm

R L Williams Company

Kowalsky


 Ft. from N. Line

330 Ft. from S. Line

330 Ft. from E. Line

 Ft. from W. Line

SE NW

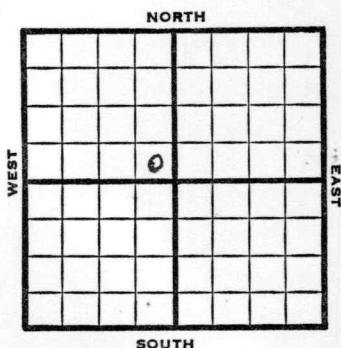

1948 Elev. 1872' REPORT

10/13 RUR

10/19 8" @ 265'
Drlg. 1705'

10/26 Topeka 2726'
Lansing 3133'
Conglomerate 3378'
TD 3415' in Cong
5" @ 3414'

11/3 "

11/10 "

11/17 Cong 3378'
5" @ 3414'
TD 345 in Cong.

~~ABANDONED~~


Map No. _____ Sec. 30 Twp. 20 R. 11WWell No. 1 Soeken "B"R. L. Williams Company

FIRST REPORT

Contractor

SE NW

SECTION PLAT

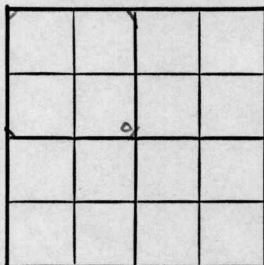

_____ Ft. from N. Line

330 Ft. from S. Line330 Ft. from E. Line

_____ Ft. from W. Line

Barton County

Location _____

Rig up _____

Drilling and Remarks:

R U R

RECORD

Cased _____ in., _____ ft.

Sand _____

Gas _____

Oil _____

Total Depth _____

PRODUCTION

1st 24 hrs. Nat. _____

1st 24 hrs. after shot _____

Gas _____ Cu. Ft.

Dry Hole _____

Abandoned _____

Date

OCT 13 1948 19

S. J. LEWIS

Scout

Map No. 46 Sec. 30 Twp. 20 R. 11W

Well No. 1 Soeken "B"

R. L. Williams Company

ABANDONED

Contractor

SE NW

E 1/8 72

SECTION PLAT

 Ft. from N. Line

330 Ft. from S. Line

330 Ft. from E. Line

 Ft. from W. Line

Barton County

Location

Rig up

Drilling and Remarks:

*Comp 3375
5" 3414*

RECORD

Cased in., ft.

Sand

Gas

Oil

Total Depth 345 in Comp

PRODUCTION

1st 24 hrs. Nat.

1st 24 hrs. after shot

Gas Cu. Ft.

Dry Hole

Abandoned

Date

NOV 17 1948

19

S. J. LEWIS

Scout