

Mc Pherson


Form 51-5M-5-34-Palace

Map No. **KANSAS** Sec. 13 Twp. 19 R. 3 W

Well No. 1 Gull Farm

Rickey Oil Company

NORTH

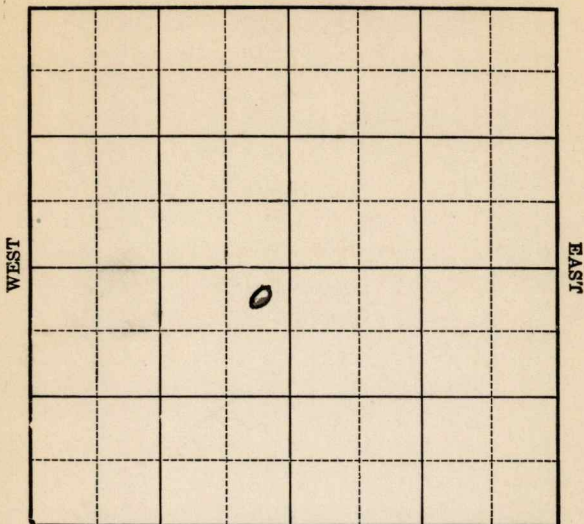

Location

Drilling Remarks

Rig Up

Drilling Remarks

RECORD

Cased _____ in. _____ ft.

Sand _____

Gas _____

Oil _____

Total Depth _____

PRODUCTION

1st 24 hrs. Nat. _____

1st 24 hrs. after shot _____

Gas _____ cu. ft.

Dry Hole _____

Abandoned _____

McPherson


Map No. **KANSAS** Sec. 13 Twp. 19 R. 3W
Well No. 1 Full Farm
Dickey oil Company

330 Ft. from N. Line

 Ft. from S. Line

330 Ft. from E. Line

 Ft. from W. Line

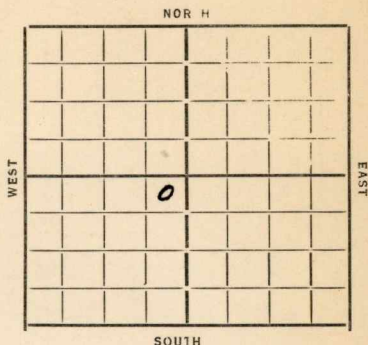

Date

REPORT

1954
9/12 Location
9/20 Bldg.
9/27 Rign up.
10/4
10/11 dly 765 15" 387
10/18 5" 1425
10/25 dly 1780
11/1 HFW 2130-40 Run 10"
11/8 10" 2140 T1 2278 20" 10"
11/15 10" 2330 KCL 2330
A.O. 2340-45 dly 2400
11/22 2470-90 HFW 8" 2562
dly 2640
11/28 " 2870
12/6 " 2940
12/13 Chit 2957
12/21 8" 2957 Est 3m Gas 2960-70
5m Gas T1 2987 flow
160 Bbls oil 9 1/2 hrs.
12/27 Run 6"
1/3/35 3006 1/2 28m Gas
(OVER)

1/9/35 Chet 2957 - 7 3006 1/2
756 Bbls
15% Water

COMPLETED

KANSAS

Form 26-1M Bks. 2-29

Map No. 43 Sec. 13 Twp. 19 R. 3NWell No. 1-TullDickey Oil

Company

Contractor

FIRST REPORTS

SECTION PLAT

	0		

330 Ft. from N. Line

_____ Ft. from S. Line

330 Ft. from E. Line

_____ Ft. from W. Line

Location ✓

Rig up _____

Drilling and Remarks:

RECORD

Cased _____ in., _____ ft.

Sand _____

Gas _____

Oil _____

Total Depth _____

PRODUCTION

1st 24 hrs. Nat. _____

1st 24 hrs. after shot _____

Gas _____ Cu. Ft.

Dry Hole _____

Abandoned _____

Date

9-12-31 19

ORVAL MANN SCHRECK Scout

Map No. 43 Sec. 13 Twp. 19 R. 3W

Well No. 1-Tull

Pickup Oil Company

Contractor

COMPLETED

SECTION PLAT

330 Ft. from N. Line

Ft. from S. Line

330 Ft. from E. Line

Ft. from W. Line

Location

Rig up

Drilling and Remarks:

756 bbl
15% water

RECORD

Cased _____ in _____ ft.

Sand Chat 2957

Gas _____

Oil _____

Total Depth 3006 1/2

PRODUCTION

1st 24 hrs. Nat. _____

1st 24 hrs. after shot _____

Gas _____ Cu. Ft.

Dry Hole _____

Abandoned _____

Date

1-9-35 192

ORVAL MANNSCHRECK

Scout