


Section 30 Township 20 Range 11W

Well No. #⁸ Jutting

Company Bay Pet.

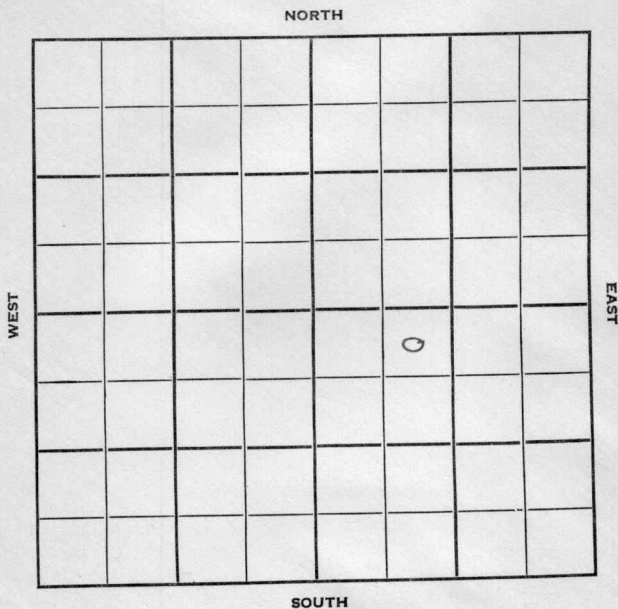

Barton

KANSAS

Sec. 30 Twp. 20 R. 11W

Well No. ~~#~~ Jutting Farm

Bay Petroleum

Company

Pickrell Drlg.

Contractor

330


Ft. from N. Line

Ft. from S. Line

Ft. from E. Line

990

Ft. from W. Line

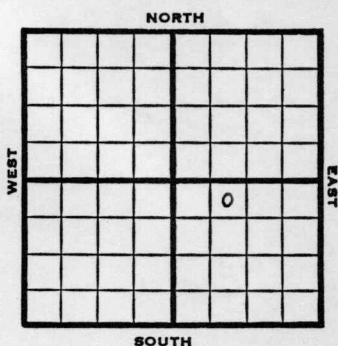SE $\frac{1}{4}$ NE NW SE

1952

Elev. 1811'

REPORT

11/5

Spud 11-3-52
8" @ 581'

11/12

Drlg. 2965'

11/19

Spud 11-3-52
 D & A TD 3403' 8" @ 581
 Br. lime 3114' Lans. 3129'
 Cong. 3367' Arb. 3394'
 DST 3394-98 open 3/4 hr. rec 7' mud
 Off TD 3403' D & A

ABANDONED

Map No. _____ Sec. 30 Twp. 20 R. 11WWell No. 8 Jutting

_____ Bay Petroleum _____ Company

_____ CORRECTION _____ Contractor


NE NW SE

SECTION PLAT

330 Ft. from N. Line

_____ Ft. from S. Line

_____ Ft. from E. Line

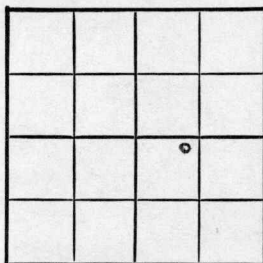990 Ft. from W. Line

Barton County

Location _____

Rig up _____

Drilling and Remarks:

Reported
#5 Jutting

RECORD

Cased _____ in., _____ ft.

Sand _____

Gas _____

Oil _____

Total Depth _____

PRODUCTION

1st 24 hrs. Nat. _____

1st 24 hrs. after shot _____

Gas _____ Cu. Ft.

Dry Hole _____

Abandoned _____


Date

NOV 5 1952 19

J. G. McGEHEE

Scout

County Barton State Kansas
 Sec. 30 (Blk.) 20 (Sur.) 11W Map No.
 Operator Bay Petroleum
 Well No. 8 Farm Jutting
 Elev. 1811 Location NE NW SE

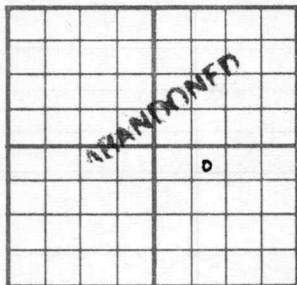

330 Ft. From N Line SE
990 Ft. From W Line Quarter

1st. Report

Completion NOV 19 1952

Remarks

Pickrell Drlg. - Contr.

Spudding Date 11-3-52

Drlg. Data D & A TD 3403

8" @ 581 Br. lime 3114 Lans. 3129

Cong. 3367 Arb. 3394 DST 3394-98

open 3/4 hr. Rec. 7' mud 0# TD 3403

D & A

J. G. McGEHEE