


Section 30 Township 20 Range 11 W

Well No. #1 Soeken

Company Frontier Oil

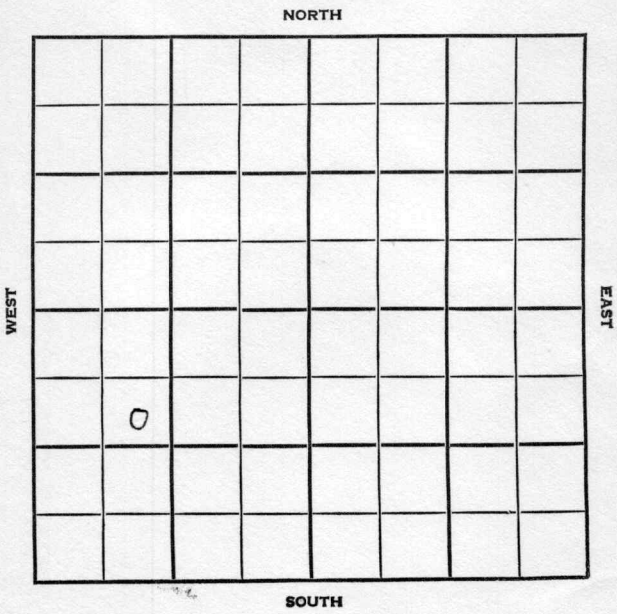

Barton

KANSAS

SEC. 30	TWP. 20	R. 11W
------------	------------	-----------

WELL NO.

#1 Soeken

FARM

COMPANY

Frontier Oil

CONTRACTOR

Rocket Drlg.
Kowalsky


_____ Ft. from N. Line

_____ Ft. from S. Line

_____ Ft. from E. Line

_____ Ft. from W. Line

SE NW SW

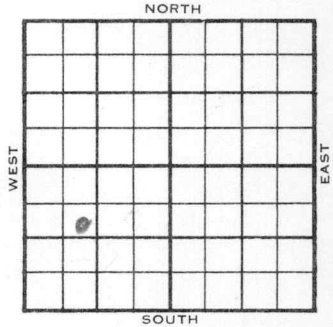

ELEVATION

REPORT

1955

1815

8/3

Comm 7-27-55

FIRST REPORT

8" @271/200 Drlg. 3175

8/10

Comm 7-27-55

Anh 575

H 3000

B1 3132

L 3146

A 3394

TD 3410

8" @ 271/200 DST 3175-3203 open 1
hr. Rec 20' ocm 0/20" DST 3394-3410
open 1 hr Rec 130' muddy sw 825/20"
D & A

ABANDONED

County Barton Elev. _____
 Sec. 30 Twp. 20 Rge. 11W
 Company Frontier Oil
 Farm Name Soeken No. 1

TOPS	DEPTH	LOG	DATUM	Loc. in Sec.	
Anh.				SE NW SW	
Tp.	
H.	
Tr.	
Dg.	
Bl.	
L.				Geol. _____	
K.C.				Contr. _____	
B.K.C.				Rocket Drlg.	
Ce.				Pool	
C.				Kowalsky	
M.				<table border="1"> <tr><td></td><td></td><td></td><td></td></tr> <tr><td></td><td></td><td></td><td></td></tr> <tr><td></td><td></td><td></td><td></td></tr> <tr><td></td><td></td><td></td><td></td></tr> <tr><td></td><td></td><td></td><td></td></tr> <tr><td></td><td></td><td></td><td></td></tr> <tr><td></td><td></td><td></td><td></td></tr> <tr><td></td><td></td><td></td><td></td></tr> <tr><td></td><td></td><td></td><td></td></tr> <tr><td></td><td></td><td></td><td></td></tr> </table>	
M.	
K.	
Mz.	
Mq.	
V.	
S.	
S.	
A.	
R.	
PE.	
G.	
T.D.	

FIRST REPORT
 AUG 3 '55

Date Comm. 7-27-55
8" @ 271/200 drlg. 3175

13

Co.
Lse.
No.
Sec.
T.
R.

County Barton Elev. 1815
 Sec. 30 Twp. 20 Rgs. 11W
 Company Frontier Oil
 Farm Name Soeken No. 1

TOPS	DEPTH	LOG	DATUM	Loc. in Sec.																
Anh.	575			SE NW SW																
TP.																				
H.	3000		1185																	
Tr.																				
Dg.																				
BL.	3132		1317	Geol.																
L.	3146		1331																	
K.C.				Contr.																
B.K.C.																				
Ce.				Rocket Drlg																
C.																				
M.				Pool																
M.																				
K.				Kowalsky																
Mz.																				
Me.				<table border="1"> <tr> <td></td> <td></td> <td></td> <td></td> </tr> <tr> <td></td> <td></td> <td></td> <td></td> </tr> <tr> <td></td> <td></td> <td></td> <td></td> </tr> <tr> <td></td> <td></td> <td></td> <td></td> </tr> </table>																
V.																				
S.																				
S.																				
A.	3394		1579	BANDONED																
R.																				
PE.				0																
G.																				
T.D.	3410																			

Date Comm. 7-27-55 AUG 10 1955

8" @ 271/200 DST 3175-3203 open 1 hr.

Rec. 20' ocm 0/20" DST 3394-3410

open 1 hr. Rec. 130' muddy sw 825/20"

D & A

Co.

Sec.

No.

Sec.

T.

R.