


DX 78-1 McPherson

KANSAS

Section 13 Township 19 Range 3W

Well No. #1 Bengston

Company Melland Drlg

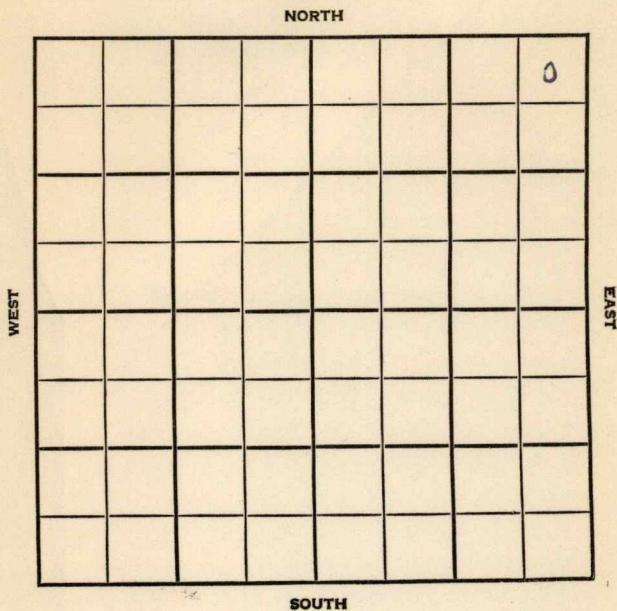

McPherson

KANSAS

SEC.	TWP.	R.
13	19	3W

WELL NO.

#1 Bengston

FARM

COMPANY

Melland Drlg.

CONTRACTOR

Co. Tools.

Chindberg Pool

NORTH

330 _____ Ft. from N. Line

_____ Ft. from S. Line

330 _____ Ft. from E. Line

_____ Ft. from W. Line

							0

WEST

EAST

SOUTH

NE NE NE

Sam Pack - DHM

ELEVATION

1545'

REPORT

1954

11/3

Surface Set

11/23

Spud 11-2-54

D & A

TD 3010'

8-5/8" @ 154'

Heeb 2098', KC 2346' Miss 2978'

DST 2991'-97' opn 1 hr rec 1200' gas,
80' hocm, 180' ocwm 270#

TD 3010'

D & A

ABANDONED

County McPherson State Kansas
 Sec. 13 (Blk.) 19 (Sur.) 3W Map No.
 Operator Melland Drlg.
 Well No. 1 Farm Bengston
 Elev. Location NE NE NE

							0

330 Ft. From N Line NE
330 Ft. From E Line Quarter
NOV 3 1954
 1st. Report

Completion

Remarks Sam Pack - DHM

Co. tools

Spudding Date

Drlg. Data

Chindberg Pool

surface set

FABEN GILSTRAP

County **McPherson** State **Kansas**Sec. **13** (Blk. Twp.) **19** (Sur. Rge.) **3W** Map No.Operator **Melland Drlg.**Well No. **1** Farm **Bengston**Elev. **1545** Location **NE NE NE**

330 Ft. From **N** Line **NE****330** Ft. From **E** Line **Quarter**

1st. Report

NOV 23 1954

Completion

Remarks **Chindberg Pool****Co. tools**Spudding Date **11-2-54**Drlg. Data **D & A** **TD 3010****8 5/8" @ 154 Heeb. 2098 KC 2346****Miss. 2978 DST 2991-97 open 1 hr.****Rec. 1200' gas 80' hocm 180' ocwm****270# TD 3010****D & A****FABEN GILSTRAP**