

Well No. 1 Swanson Farm

Roth & Farrot Company

WEST

EAST

SOUTH

on DD

Rig Up_____

Drilling Remarks

PRODUCTION

1st 24 hrs. Nat.-----

1st 24 hrs. after shot_____

Gas_____cu. ft._____

Dry Hole_____

Abandoned_____

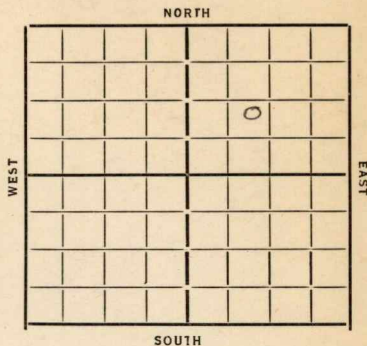
McPherson

Map No. _____ Sec. 13 Twp. 19 R. 3^WWell No. #1 Swanson FarmRoth & Hawrot Company

_____ Ft. from N. Line

990 Ft. from S. Line

_____ Ft. from E. Line

990 Ft. from W. LineDate
1933

REPORT

4/5 R.O.G.
4/12 Rig
4/19 Spudding
4/26 26"-76'-15"-391 dily 393'
5/4 dily 1075
5/10 12"-1112' 10"-1400' dily 1410'
5/17 T.D. 1800 U.R. 10"
5/24 10"-1790' dily 2100'
6/1 8" 2225 dily 2340
6/8 HFW 2365 U.R. 10" 2370'
6/15 8" 2680 dily 2700'
6/21 U.R. 8" 2800 S.D. 2805'
6/28 Chat 2937 T.D. 2947 1/4 M gas U.R. 8"
7/5 —
7/12 2959 10 Mil. gas S.D.
7/19 —
7/26 26 1/2 M gas T.D. 2961 shut in
8/2 —
8/9 Top chat 2937
T.D. 2961
26 1/2 M Gas

COMPLETED

OVER

1934

OWDD

7/25 OTD 2961 Rgn up.

8/2 2994 22m Gas & S.O.

8/9 Wly 3005

8/16 TD 3010 Pay 3007-10
Flow 750 Bbls 24 hrs.

8/22 Oil 3007-10 TD 3010
476 Bbls.

COMPLETED

McPherson

w

43

KANSAS

Map No. _____ Sec. 13 Twp. 19 R. 3

Well No. 1 Swanson

Roth & Farnat

Company

Contractor

FIRST REPORTS

SECTION PLAT

_____ Ft. from N. Line

990 _____ Ft. from S. Line

_____ Ft. from E. Line

990 _____ Ft. from W. Line

		o	

Location _____

Rig up _____

Drilling and Remarks:

R.O.S.

RECORD

Cased _____ in., _____ ft.

Sand _____

Gas _____

Oil _____

Total Depth _____

PRODUCTION

1st 24 hrs. Nat. _____

1st 24 hrs. after shot _____

Gas _____ Cu. Ft.

Dry Hole _____

Abandoned _____

Date

APR 5 1933 192 CHAS. L. SHERWOOD Scout

Map No. 43 Sec. 13 Twp. 19 R. 3W

Well No. 1 - Swanson

Rath & Parrot Company

Contractor

COMPLETED

SECTION PLAT

Ft. from N. Line

990 Ft. from S. Line

Ft. from E. Line

990 Ft. from W. Line

		o	

Location

Rig up

Drilling and Remarks:

26 1/2 mil gas

RECORD

Cased shot 2937 in. ft.

Sand

Gas

Oil

Total Depth 2961

PRODUCTION

1st 24 hrs. Nat.

1st 24 hrs. after shot

Gas Cu. Ft.

Dry Hole

Abandoned

Date

8/9/33 192 C. Mannschied Scout

Map No. 43 Sec. 13 Twp. 19 R. 3WWell No. 1-SwansonRoth + Maurat

Company

Contractor

FIRST REPORTS**SECTION PLAT**

		0	

Ft. from N. Line

990 Ft. from S. Line

Ft. from E. Line

990 Ft. from W. Line

Location _____

Rig up _____

Drilling and Remarks:

OTD 2961

Rig up

RECORD

Cased _____ in., _____ ft.

Sand _____

Gas _____

Oil _____

Total Depth _____

PRODUCTION

1st 24 hrs. Nat. _____

1st 24 hrs. after shot _____

Gas _____ Cu. Ft.

Dry Hole _____

Abandoned _____

Date

7-25-34 19

ORVAL MANNSCHRECK

Scout

KANSAS

Map No. 43 Sec. 13 Twp. 19 R. 3W

Well No. 1-Swanson

Roth & Traut

Company

Contractor

COMPLETED
ABANDONED

SECTION PLAT

		0	

990 Ft. from N. Line

990 Ft. from S. Line

990 Ft. from E. Line

990 Ft. from W. Line

COMPLETED

Location

Rig up

Drilling and Remarks:

476 bbls

RECORD

Cased _____ in., _____ ft.

Sand _____

Gas _____

Oil 3007-10

Total Depth 3010

PRODUCTION

1st 24 hrs. Nat. _____

1st 24 hrs. after shot _____

Gas _____ Cu. Ft.

Dry Hole _____

Abandoned _____

ORVAL MANNSCHRECK

Date

8-22-37 19

Scout