

SOUTH

KANSAS

Barton

Sec. 31 Twp. 20 R. 11W

Well No. #3 D. C. Johnson Farm

Shell

Kowalsky Pool Company


330' Ft. from N. Line

Ft. from S. Line

Ft. from E. Line

330' Ft. from W. Line

NW NE

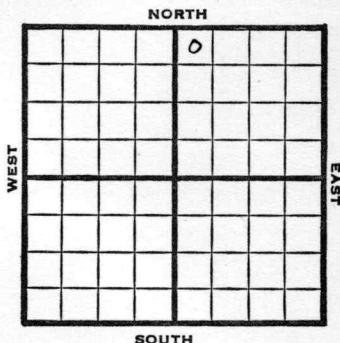

1948

E₁ 1875'

REPORT

5/26 Drlg. 285'

6/1 8" @ 300'

Drlg. 3025'

6/9 Lansing 3145'
Arbuckle 3369'
TD 3394'
500 acid

6/16 "

6/23 TD 3394'
Arb. 3369'
4" @ 3370'
A band.

ABANDONED

Map No. _____ Sec. 31 Twp. 20 R. 11W

Well No. 3 D. C. Johnson

Shell _____ Company

FIRST REPORT

Contractor

NW NE


SECTION PLAT

330 Ft. from N. Line

_____ Ft. from S. Line

_____ Ft. from E. Line

330 Ft. from W. Line

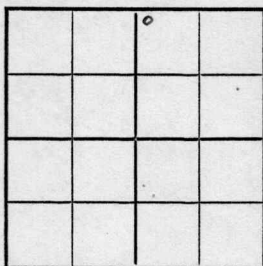

Barton County

Location _____

Rig up _____

Drilling and Remarks:

drlg. 285

RECORD

Cased _____ in., _____ ft.

Sand _____

Gas _____

Oil _____

Total Depth _____

PRODUCTION

1st 24 hrs. Nat. _____

1st 24 hrs. after shot _____

Gas _____ Cu. Ft.

Dry Hole _____

Abandoned _____

Date

MAY 26 1948 19 S. J. LEWIS Scout

Map No. 46 Sec. 31 Twp. 20 R. 11W

Well No. 3 D. C. Johnson

Shell Company

ABANDONED

Contractor

NW NE


E 1, 1875
SECTION PLAT

330 Ft. from N. Line

 Ft. from S. Line

 Ft. from E. Line

330
 Ft. from W. Line

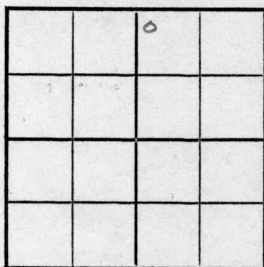

Barton County

RECORD

Location

Rig up

Drilling and Remarks:

*Per 73369
4" Q370*

Cased in., ft.

Sand

Gas

Oil

Total Depth 3394

PRODUCTION

1st 24 hrs. Nat.

1st 24 hrs. after shot

Gas Cu. Ft.

Dry Hole

Abandoned

Date

JUN 23 1948 19 S. J. LEWIS Scout