

McPherson


KANSAS

SECTION 13 TOWNSHIP 19 RANGE 3 W

WELL NO. #1 Swanson

COMPANY Geo. Hess et al

NORTH

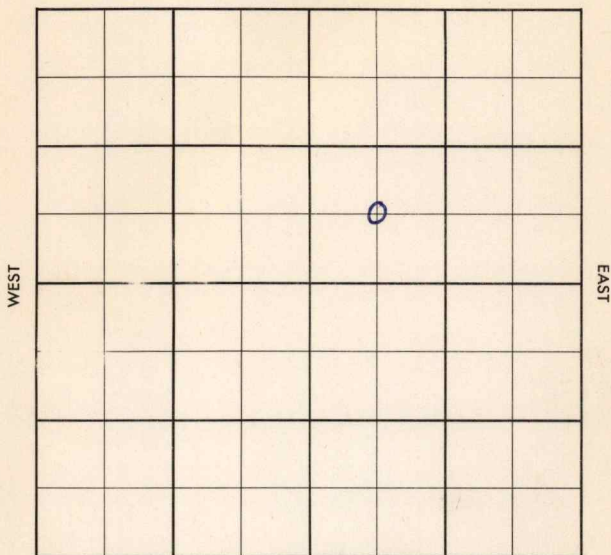

SOUTH

McPherson

KANSAS

SEC.

TWP.

R.

13

19

3W

WELL NO.

#1 Swanson

FARM

COMPANY

Geo Hess et al

CONTRACTOR

Mallard

Chindberg


Ft. from N. Line

Ft. from S. Line

Ft. from E. Line

Ft. from W. Line

C SW NE

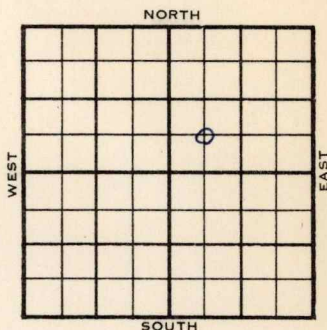

1955

ELEVATION

1536'

REPORT

11/9

Comm 11-4-55

~~8 1/2~~ 8" @ 155/90

Drlg 1950

1956

1-11

5 1/2" @ 2994/40#

DD 3017

SSO, 100 bwpd,

PB 2370, 15/ 2336-41, 1000 A,

1 bo, 1 1/2 bwph

Comp. 4 bopd, 10 bw.

L. 2326'

M. 2957

TD 2996'

COMPLETED

~~McPherson~~

County

Elev.

Sec.

13

Twp.

19

Rge.

3W

Company

~~Geo. Hess et al.~~

Farm Name

~~Swanson~~

No.

1

TOPS

DEPTH

LOG

DATUM

Loc. in Sec.

Anh.

C SW NE

Tp.

H.

Tr.

Dg.

Bl.

L.

K.C.

Geol.

B.K.C.

Ce.

Contr.

C.

Mallard

M.

M.

Pool.

K.

Chindbe rg

Mz.

Mq.

V.

S.

S.

A.

R.

P.E.

G.

T.D.

NOV 2 1955	0
FIRST REPORT	

Date Comm.

11-4-55

8" @ 155/90 drlg. 1950

County

McPherson

Elev.

1536

Sec.

13

Twp.

19

Rge.

3W

Company

Geo. Hess et al.

Farm Name

Swanson

No.

1

TOPS	DEPTH	LOG	DATUM	Loc. in Sec.
Anh.				C SW NE
Tp.				
H.				
Tr.				
Dg.				
BL.				
L.	2326		790	Geol.
K.C.				Contr.
B.K.C.				Mallard
Ce.				Pool
C.				Chindberg
M.	2957		1421	
M.				
K.				
Mz.				
Mq.				
V.				
S.				
S.				
A.				
R.				
Pe.				
G.				
T.D.	2996			COMPLETE

Date Comm.

11-4-55

JAN 11 1956

8" @ 155/90

5 $\frac{1}{2}$ " @ 2994/40

DD 3017

SSO

100 bwpd

PB 2370

15/ 2336-41

1000 A

1 bo

1 $\frac{1}{2}$ bwph

Comp.

4 bopd

10 bw