


Section 13 Township 19 Range 3W **KANSAS**

Well Number 2 Bengston

Company Nadel Oil

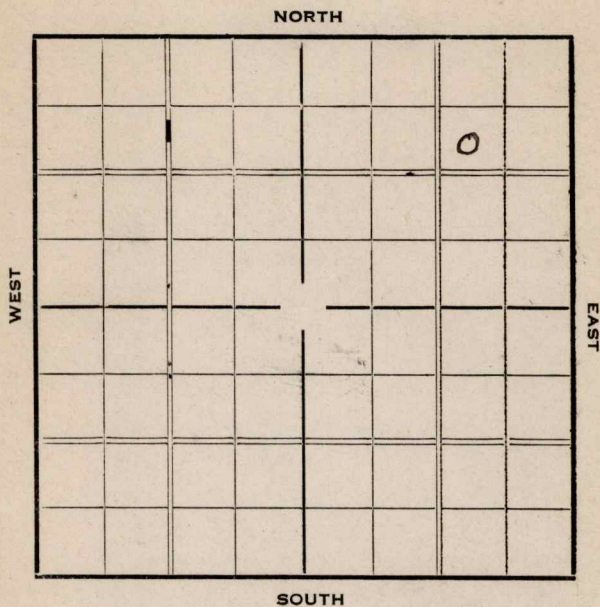

Sec. 13 Twp. 19 R. 3-W

Well No. #2 Bengston Farm

Nadel Oil Company


990 Ft. from N. Line

Ft. from S. Line

990 Ft. from E. Line

_____Ft. from W. Line

Elev 1543

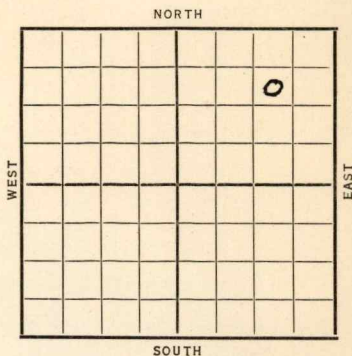[illegible]


Contractor

SECTION PLAT

			o

990 Ft. from N. Line

Ft. from S. Line

990 Ft. from E. Line

Ft. from W. Line

FIRST REPORT

Location _____

Rig up _____

Drilling and Remarks:

Rigging up**RECORD**

Cased _____ in., _____ ft.

Sand _____

Gas _____

Oil _____

Total Depth _____

PRODUCTION

1st 24 hrs. Nat. _____

1st 24 hrs. after shot _____

Gas _____ Cu. Ft.

Dry Hole _____

Abandoned _____

Date

NOV 18 1936 19

S. J. LEWIS

Scout

KANSAS

Map No. 43 Sec. 13 Twp. 17 R. 3WWell No. 2 BengstonCompany Nadel Oil

Contractor _____

SECTION PLAT

			0

990 Ft. from N. Line

_____ Ft. from S. Line

990 Ft. from E. Line

_____ Ft. from W. Line

ABANDONED

Location _____

Rig up _____

Drilling and Remarks:

Ok 82965HPWLJA

RECORD

Cased _____ in., _____ ft.

Sand _____

Gas _____

Oil _____

Total Depth 3010

PRODUCTION

1st 24 hrs. Nat. _____

1st 24 hrs. after shot _____

Gas _____ Cu. Ft.

Dry Hole _____

Abandoned _____

Date

JAN 6 1937 19S. J. LEWIS

Scout