
McPherson

Form 51—5M—5-34—Palace

Map No. KANSAS Sec. 13 Twp. 19 R. 3W

Well No. 2 Tull Farm

Dickey Oil Company

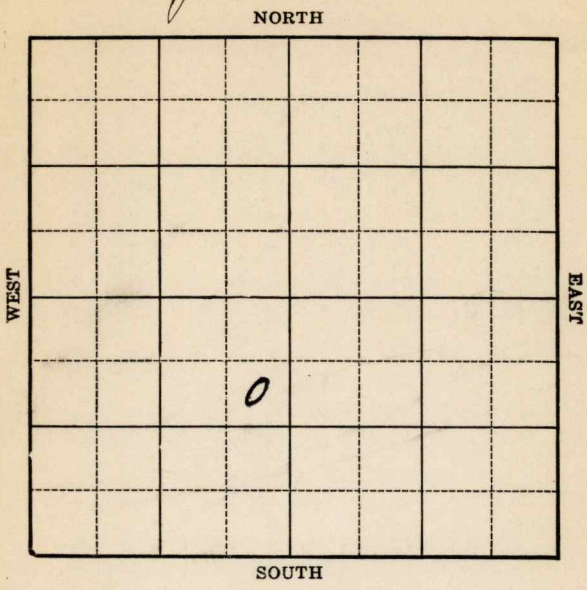

Location

Drilling Remarks

Rig Up

Drilling Remarks

RECORD

Cased ____ in. ____ ft.

Sand

Gas

Oil

Total Depth

PRODUCTION

1st 24 hrs. Nat.

1st 24 hrs. after shot

Gas ____ cu. ft.

Dry Hole

Abandoned

Form 252-A
5M 7-34 MPC

McPherson

Map No. KANSAS Sec. 13 Twp. 19 R. 3W

Well No. 2 Tull Farm


Dickey Oil Company

990 Ft. from N. Line

_____ Ft. from S. Line

330 Ft. from E. Line

_____ Ft. from W. Line

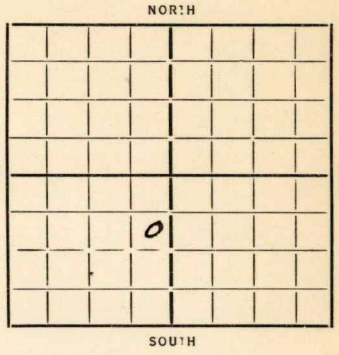

Date 1935	REPORT
1/9	Cellar
1/17	Bldg
1/24	Rig
1/31	Bldg 52
2/7	5" 400 15" 385
2/14	—
2/21	Bldg 585
2/28	" 1300
3/7	" 1445 12½" 1410
3/14	" 1700
3/21	" 2075 10" 1785
3/28	" 2205
4/4	2325 WR 10"
4/11	RC 2335 10" 2340
	Bldg 2493
4/18	8" 2550 TD 2712 WR
4/26	8" 2688 Co.
5/2	T Chat 2955 Sq 2955-57
	2978 9M Gas Sand 2990-98
	23M Gas P.B.P.
5/9	6" 2998
5/16	—

(OVER)

5/23 fog 2998 6" 2974
5/29 — 6/6 — 6/13 — 6/20 —
6/28 —
7/3 5" 2955 TJ 2972
7/11 fog
7/18 PB KC
8/8 — 8/15 — 8/22 — 8/29 —
9/6 SJ 2972
10/3 — 10/10 —
10/24 Chat 2955
TD 2972
PB 2535
D. & A.

ABANDONED

Form 26—1M Bks. 9-28

McPherson

KANSAS

Map No. 43 Sec. 13 Twp. 19 R. 3W

Well No. 2- Tull

Kirby Oil Company

Contractor

FIRST REPORTS


SECTION PLAT

990 Ft. from N. Line

Ft. from S. Line

330 Ft. from E. Line

Ft. from W. Line

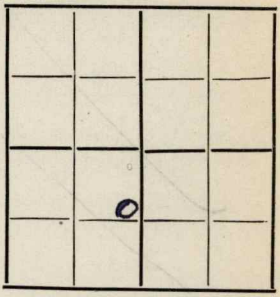

Location

Rig up

Drilling and Remarks:

cellar

RECORD

Cased in., ft.

Sand

Gas

Oil

Total Depth

PRODUCTION

1st 24 hrs. Nat.

1st 24 hrs. after shot

Gas Cu. Ft.

Dry Hole

Abandoned

Date

1-9-35 192

ORVAL MANNSCHRECK Scout

Form 26—1M Bks—8-28

McPherson

KANSAS

Map No. 43 Sec. 13 Twp. 19 R. 3W

Well No. 2-Tull

Kirkey Oil Company

Contractor

ABANDONED


990 Ft. from N. Line

Ft. from S. Line

330 Ft. from E. Line

Ft. from W. Line

SECTION PLAT

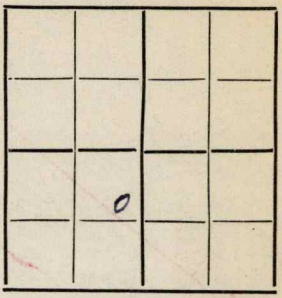

Location

Rig up

Drilling and Remarks:

PB 2335

10 ft

RECORD

Cased in., ft.

Sand Chat 2955

Gas

Oil

Total Depth 2972

PRODUCTION

1st 24 hrs. Nat.

1st 24 hrs. after shot

Gas Cu. Ft.

Dry Hole

Abandoned

Date

10-27-35 192

ORVAL MANNSCHRECK Scout