


Mc Pherson

Form 51-5M-5-34-Palace

Map No. **KANSAS** Sec. 13 Twp. 19 R. 3W

Well No. 3 Almen Farm
Roth & Gaurot Company

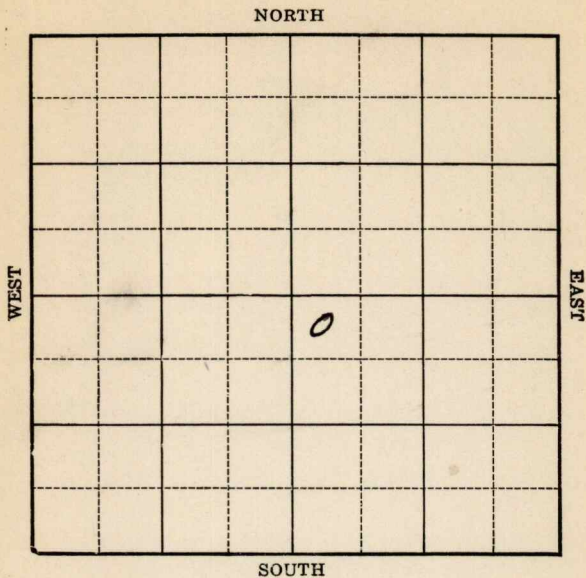

Location

Drilling Remarks

Rig Up

Drilling Remarks

RECORD

Cased _____ in. _____ ft.

Sand _____

Gas _____

Oil _____

Total Depth _____

PRODUCTION

1st 24 hrs. Nat. _____

1st 24 hrs. after shot _____

Gas _____ cu. ft.

Dry Hole _____

Abandoned _____

Mc Pherson

Map No. KANSAS Sec. 13 Twp. 19 R. 3W


Well No. 3 Almer Farm
Rath & Faust Company

330 Ft. from N. Line

_____ Ft. from S. Line

_____ Ft. from E. Line

330 Ft. from W. Line

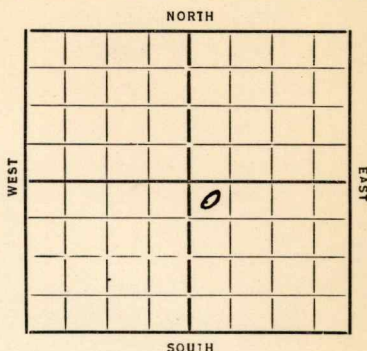

~~1984~~

REPORT

10/17 Rig Bldg
10/25 — 11/1 — 11/8 —
11/15 Bldg
11/22 Rign
11/28 — 12/4 — 12/13 — 12/21 —
12/27 — 1/3/35 — 1/10 — 1/17 —
1/24
1/31 15" 389 57 540
2/7 Bldg 1362
2/14 " 1915 12" 1382 10" 1790
2/21 Bldg 2240 HFW 2145
2/28 KC 2335 S.O. 2338-45
10" 2351 Bldg 2450
3/7 Bldg 2495
3/14 " 2790 8" 2696
3/21 Chrt 2950 Gas 2962
T 2997 147m Gas UR 8"
3/28 —
4/3 Chrt 2950 T 3006
flow 1445 Bbls.

COMPLETED

KANSAS

Map No. 43 Sec. 13 Twp. 19 R. 3W

Well No. 3 - Almen

Roth & Traut Company

Contractor

SECTION PLAT

330 Ft. from N. Line

_____ Ft. from S. Line

_____ Ft. from E. Line

330 Ft. from W. Line

		0	

Location ✓

Rig up _____

Drilling and Remarks:

Rig Bedg

RECORD

Cased _____ in., _____ ft.

Sand _____

Gas _____

Oil _____

Total Depth _____

PRODUCTION

1st 24 hrs. Nat. _____

1st 24 hrs. after shot _____

Gas _____ Cu. Ft.

Dry Hole _____

Abandoned _____

Date

10-17-34 19

ORVAL MANNSCHRECK

Scout

Map No. 43 Sec. 13 Twp. 19 R. 3W

Well No. 3-Almen

Roth & Traurat Company

Contractor

COMPLETED

SECTION PLAT

		0	

330 Ft. from N. Line

..... Ft. from S. Line

..... Ft. from E. Line

330 Ft. from W. Line

Location

Rig up

Drilling and Remarks:

Flow
1445 bbls

RECORD

Cased..... in., ft.

Sand Chat 2950

Gas

Oil

Total Depth 3006

PRODUCTION

1st 24 hrs. Nat.

1st 24 hrs. after shot

Gas Cu. Ft.

Dry Hole

Abandoned

Date

ORVAL MANNSCHECK

4-3-35 192 Scout