McPherson


KANSAS

Form 51—5M—11-31—Palace

Map No. ____ Sec. 13 Twp. 19 R. 3W

Well No. 3 Swanson Farm

Roth & Faurot Company

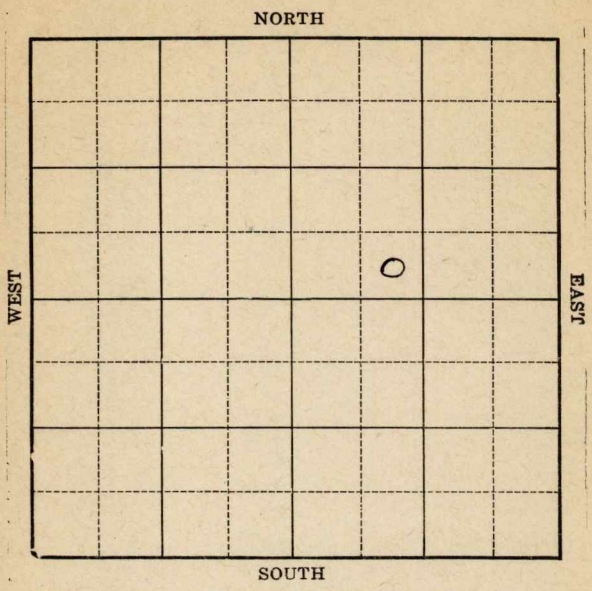

Location	Rig Up
Drilling Remarks	Drilling Remarks

RECORD		PRODUCTION	
Cased	in. ft.	1st 24 hrs. Nat.	
Sand		1st 24 hrs. after shot	
Gas		Gas	cu. ft.
Oil		Dry Hole	
Total Depth		Abandoned	


McPherson

Form 252-A
5M 4-32 MPC

Map No. KANSAS Sec. 13 Twp 19 R. 3W

Well No. 3 Swanson Farm

Roth & Fawcett Company

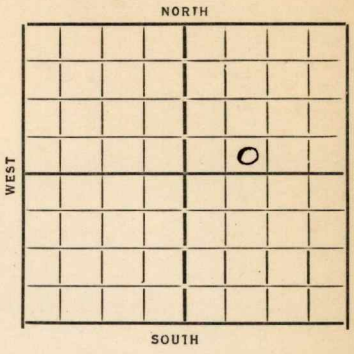

____ Ft. from N. Line

330 Ft. from S. Line

____ Ft. from E. Line

990 Ft. from W. Line

Date 1934	REPORT
3/4	Location
3/15	Bldg. Rig
3/22	Rig
3/29	—— 4/5 —— 4/12 ——
4/19	——
4/26	Rigg up
5/3	26" 70'
5/10	Dly 835 15" 394
5/18	" 1735 12" 1382
5/25	10" 2030 TD 2061 C.O.
5/31	——
6/7	Dly 2490
6/14	" 2682 10" 2353
6/21	WR 8" 2864
6/28	TC 2948 TD 2957 WR 8"
7/5	Dly 2991
7/12	TD 2992 Run 6"
7/19	Cem 7" 2990 TD 2996 Dly plug
7/25	Chat 2948 TD 3012
	Pay 3007-12 520 oil 88 water

COMPLETED

Form 26—1M Bks.—9-28

Map No. 43 Sec. 13 Twp. 19 R. 3W

Well No. 3—Swanson

Roth & Faurot Company

Contractor

FIRST REPORTS


330 Ft. from N. Line

Ft. from S. Line

Ft. from E. Line

990 Ft. from W. Line

SECTION PLAT

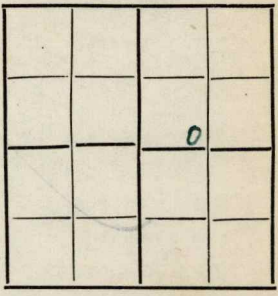

Location ✓

Rig up

Drilling and Remarks:

RECORD

Cased in., ft.

Sand

Gas

Oil

Total Depth

PRODUCTION

1st 24 hrs. Nat.

1st 24 hrs. after shot

Gas Cu. Ft.

Dry Hole

Abandoned

Date

3-7-34 192 O. Mannucheck Scout

Form 26—1M Bks.—2-29

Republican KANSAS

Map No. 43 Sec. 13 Twp. 19 R. 3W


Well No. 3—Swanson

Roth & Faurot Company

Contractor

COMPLETED

SECTION PLAT

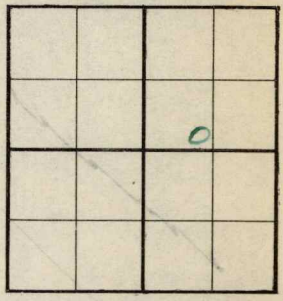

Ft. from N. Line

330 Ft. from S. Line

Ft. from E. Line

990 Ft. from W. Line

Location

Rig up

Drilling and Remarks:

pay 3007-12

520 oil

8 water

RECORD

Cased in., ft.

Sand Chat 2948

Gas

Oil

Total Depth 3012

PRODUCTION

1st 24 hrs. Nat.

1st 24 hrs. after shot

Gas Cu. Ft.

Dry Hole

Abandoned

Date

7-25-34 19

ORVAL MANNSCHRECK Scout