


KANSAS Barton

FORM 51 IOM 12-46 PETROL

Section 32 Township 20 Range 11W

Well No. 1 Kowalsky

Company Bay Pet.

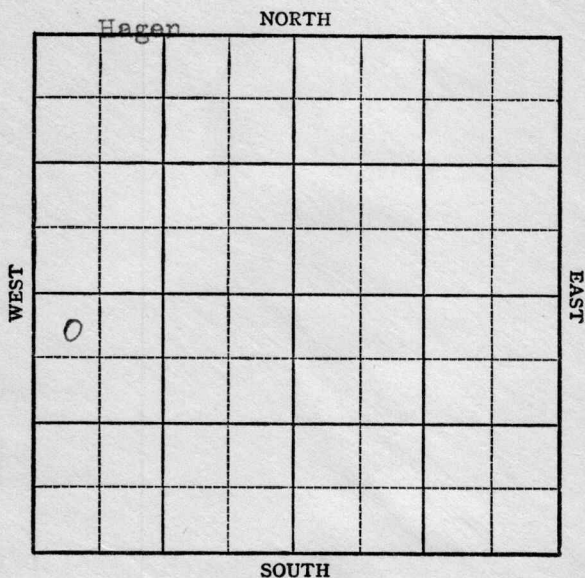

KANSAS

Barton

Sec. 32 Twp. 20 R. 11-W

Well No. 1 Kowalsky Farm

Bay Pet. Company

Hagen Pool


330 Ft. from N. Line

Ft. from S. Line

Ft. from E. Line

330 Ft. from W. Line

NW SW

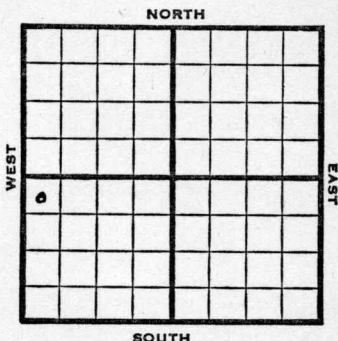

1947 Elev. 1809' REPORT

9/3 Loc.

9/10 8" @ 209'
TD 2630'
SP Collapsed skid rig 12'
East

9/17 8" @ 560'
Drilg. 1200'

9/24 Lansing 3119'
Arbuckle 3362'
TD 3368'
5" @ 3366'
RUST

10/1 Corrected Lansing 3117'
Simpson 3359'
Arbuckle 3365'
5" @ 3369'
TD 3373'
2800' oil 1½ hrs.

10/8 "

10/15 "

10/22 Arbuckle 3365'
5" @ 3369'
Pump 458 Pot
Gr. 48°
Total Depth 3373'

COMPLETED

Map No. _____ Sec. 32 Twp. 20 R. 11W

Well No. 1 Kowalsky

Bay Pet. _____

Company _____

FIRST REPORT

Contractor _____

NW SW


SECTION PLAT

330 Ft. from N. Line

_____ Ft. from S. Line

_____ Ft. from E. Line

330 Ft. from W. Line

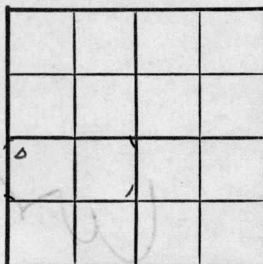

Barton County

Location X

Rig up _____

Drilling and Remarks: _____

RECORD

Cased _____ in., _____ ft.

Sand _____

Gas _____

Oil _____

Total Depth _____

PRODUCTION

1st 24 hrs. Nat. _____

1st 24 hrs. after shot _____

Gas _____ Cu. Ft.

Dry Hole _____

Abandoned _____

Date

SEP 3 1947 19 _____ S. J. LEWIS Scout

Map No. 46 Sec. 32 Twp. 20 R. 11W

Well No. 1 Kowalsky

Bay Pet. Company

COMPLETE

Contractor

NW SW

E11809

SECTION PLAT

6			

330 Ft. from N. Line

 Ft. from S. Line

 Ft. from E. Line

330 Ft. from W. Line

Barton County

Location

Rig up

Drilling and Remarks:

Cell 3365

5-103365

Run 458 BX

480 cu

RECORD

Cased in., ft.

Sand

Gas

Oil

Total Depth 3873

PRODUCTION

1st 24 hrs. Nat.

1st 24 hrs. after shot

Gas Cu. Ft.

Dry Hole

Abandoned

Date

OCT 22 1947 19

S. J. LEWIS

Scout