


Section 19 Township 19 Range 3W

Well No. #1 Miller

Company Musgrove Pet.

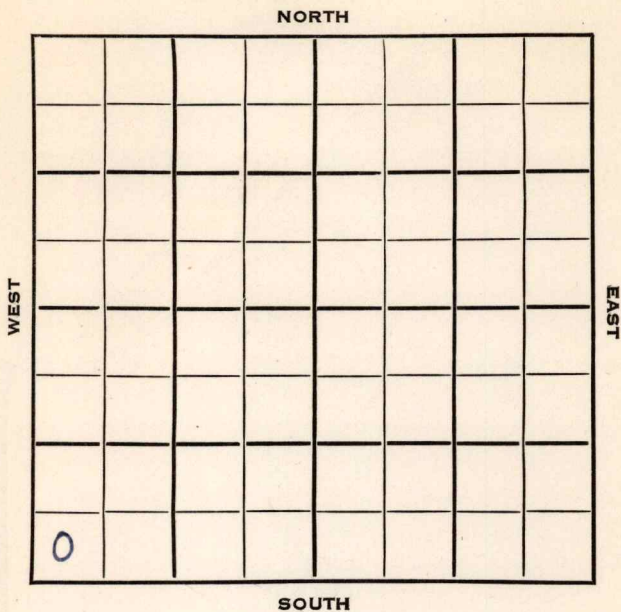


SEC. 19 TWP. 19 R. 3W McPherson KANSAS

WELL NO. #1 Miller FARM

COMPANY Musgrove Pet.

CONTRACTOR Musgrove

Wildcat.

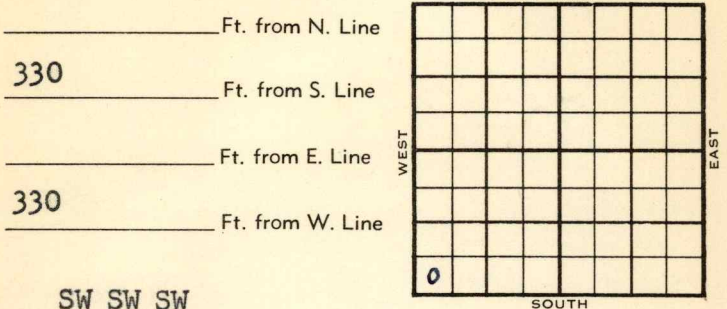

1953 ELEVATION 1500' REPORT

12/22 m i r

1954 1/6 8" @ 561'

Lans 2516', Miss 3150' Drlg. 3562'

1/13 Spud 12-26-53 D & A TD 3865' 8" @ 561 Lans. 2516' Miss. 3150'


Maq. 3667' Viola 3713'

DST 3708-21 open 1 hr rec 10' mud 110# Simp. 3749'

DST 3748-55, open 1 hr rec 15' mud 1165# Arb. 3815' TD 3865' D & A

ABANDONED

County McPherson State Kansas
 Sec. 19 (Blk.) 19 (Sur.) 3W Map No.
 Operator Musgrove Pet.
 Well No. 1 Farm Miller
 Elev. _____ Location SW SW SW

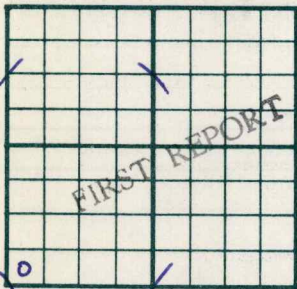

330 Ft. From S Line SW
330 Ft. From W Line Quarter

1st. Report DEC 22 1953

Completion _____

Remarks _____

Musgrove - Contr.

Spudding Date _____

Drlg. Data _____

Wildcat

M I R

County McPherson State Kansas
 Sec. 19 (Blk.) 19 (Sur.) 3W Map No.
 Operator Musgrove Pet.
 Well No. 1 Farm Miller
 Elev. 1500 Location SW SW SW



330 Ft. From S Line SW
330 Ft. From W Line Quarter

1st. Report

Completion JAN 13 1954

Remarks Wildcat

Musgrove - Contr.

Spudding Date 12-26-53

Drlg. Data D & A TD 3865

8" @ 561 Lans. 2516 Miss. 3150

Maq. 3667 Viola 3713 DST 3708-21

open 1 hr. Rec. 10' mud 110#

Simp. 3749 DST 3748-55 open 1 hr.

Rec. 15' mud 1165# Arb. 3815 TD 3865

D & A