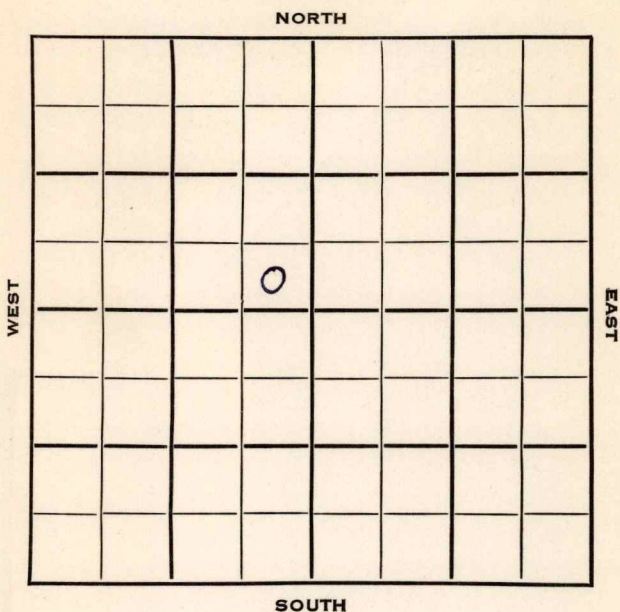


Section 18 Township 19 Range 3WWell No. #1 KinsingerCompany LaFayette Oil

McPherson

KANSAS

Sec. 18 Twp. 19 R. 3WWell No. #1 Kinsinger FarmLaFayette Oil Company

Contractor


Wildcat.

Ft. from N. Line

330 Ft. from S. Line330 Ft. from E. Line

Ft. from W. Line

SE SE NW

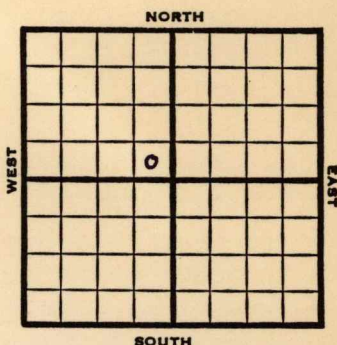

1953

Elev. 1492'

REPORT

8/12

M I M

8/12

8" @ 574
Drlg. 2230'

8/19

Lans 2493, Mss 3145, B Osage 3367,
K H 3411, Mq dol 3637, V 3696
Drlg 3736

8/26

Spud 8-4-53

D&A

TD 3832

8" @ 574

Lans 2493, Miss 3145, B. Osage
3367, Kh. 3411, Maq 3637, Viola
3696, Simp 3732, Arb. 3802

TD 3832

D&A

ABANDONED

J. G. McGEHEE