

Barton

FORM 51

KANSAS

Section 33 Township 20 Range 11W

Well No. 1 - Metz

Company Buick Drlg

NORTH

			0				

WEST

EAST

SOUTH

Sec. 33 Twp. 20 R. 11 WWell No. # 1 Metz Farm

Buick Drlg.

Company

Buick Drlg.

Contractor

Wildcat

330

Ft. from N. Line


Ft. from S. Line

330

Ft. from E. Line

Ft. from W. Line

NE NE SW

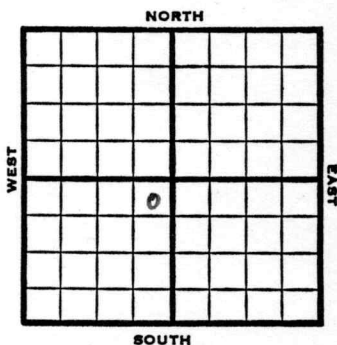

1953

Elev. 1792'

REPORT

1/21

Spud 1-18-53
8" @ 283'

1/29

Drlg. 2955'

2/5

Heeb 3530, Br 1i 3102, Lans
3125
DST 3160-3200, 3/4 hrs., 1100'
gas, 300' HOCM, 200' OCM, 917#
Cong 3376
RTD 3530
5" @ 3200

2/12

CO 3235
6/3170-72, 6/3172-74, 500A
S/4 BW + $\frac{1}{2}$ BOPH
11/3186-90, tub a/packer 500A
S/1 $\frac{1}{2}$ BW + 3 $\frac{1}{2}$ goph

2/19

NR

2/26

Sq all perfs 12/3170-74,
S/12 BW + 2 BO
18/3186-92, 6 BW + 2 FOPH drove
plug to 3200
S/18 BO + 71 BW 12 hrs., POP

3/12

NR

3/19

"

OVER

1953
3/26 NR
4/2 "
4/9 NR
4/16 P/12 BO / 288 Bwpd
4/23 NR
4/30 NR
5/7 "
5/21 "
5/28 "
6/3 NR
7/8 "
7/22 Spud 1-18-53
D&A
TD 3530
8" @ 283
Lans 3125
DST 3160-3200, opn 3/4 hrs., rec. 1100'
gas, 300' hocm, 200' ocm, 917#
Arb. 3515
TD 3530,
5" @ 3264
Heeb 2980, Br lime 3102, Cong 3376
CO to 3235
6/3170-72, 6/3172-74, 500A
S/4 bw $\frac{1}{2}$ boph, 11/3186-90, 500A
S/1 $\frac{1}{2}$ bw 3 $\frac{1}{2}$ goph, 12/3170-74
S/12 bw 2 bo 18/3186-92,
S/6 bw 2 boph
DP to 3200, S/18 bo 71 bw 12 hrs.
P/12 bopd 288 bw
D&A

ABANDONED


County Barton State Kansas
 Sec. 33 (Blk.) 20 (Sur.) 11W Map No.
 (Twp.) (Rge.)
 Operator Buick Drlg.
 Well No. 1 Farm Metz
 Elev. Location NE NE SW



330 Ft. From N Line SW
330 Ft. From E Line Quarter
 1st. Report JAN '1 1953
 Completion
 Remarks
Buick Drlg. - Contr.
 Spudding Date 1-18-53

Drlg. Data Wildcat
8" @ 283

County Barton State Kansas
 Sec. 33 (Blk.) 20 (Sur.) 11W Map No.
 Operator Buick Drlg.
 Well No. 1 Farm Metz
 Elev. 1792 Location NE NE SW

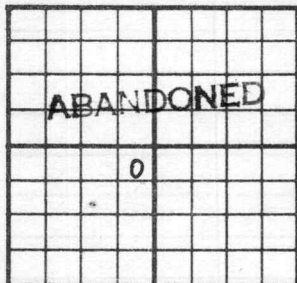

330 Ft. From N Line SW

330 Ft. From E Line Quarter

1st. Report

Completion JUL 22 1953

Remarks Wildcat

Buick Drlg. - Contr.

Spudding Date 1-18-53

Drlg. Data D & A TD 3530

8" @ 283 Lans. 3125 DST 3160-3200

open 3/4 hr. Rec. 1100' gas 300' hoem

200' ocm 917# Arb. 3515 TD 3530

5" @ 3264 Heeb. 2980 Br. lime 3102

Cong. 3376 CO to 3235 6/ 3170-72

6/ 3172-74 500 A S/ 4 bw 1/2 boph

11/ 3186-90 500 A S/ 1 1/2 bw 3 1/2 goph

12/ 3170-74 S/ 12 bw 2 bo 18/ 3186-92

S/ 6 bw 2 boph DP to 3200 S/ 18 bo

71 bw 12 hr. P/ 12 bopd 288 bw

D & A

J. G. McGEHEE