


Section #1 Hager Township \_\_\_\_\_ Range \_\_\_\_\_

Well No. Alpine Oil & Royalty

Company \_\_\_\_\_

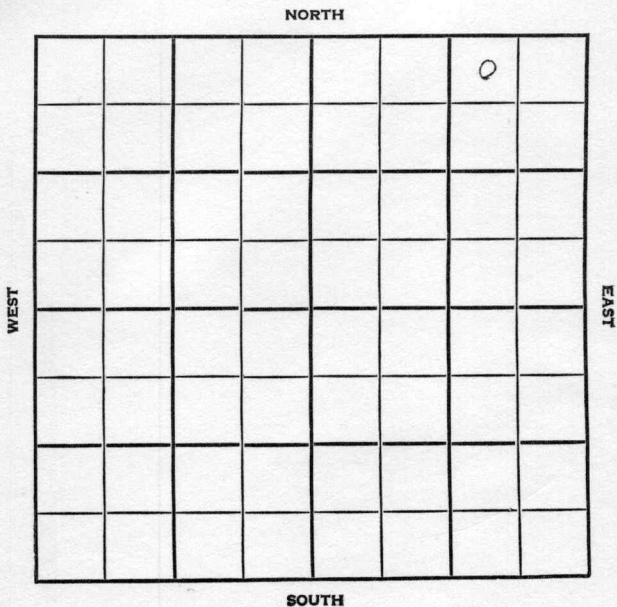

SEC. 34	TWP. 20S	R. 11W
------------	-------------	-----------

WELL NO. 1 Hagen FARM

COMPANY

Alpine Oil & Royalty

CONTRACTOR


Quaker rig #2  
(WILDCAT)

\_\_\_\_\_ FT. FROM N. LINE

\_\_\_\_\_ FT. FROM S. LINE

\_\_\_\_\_ FT. FROM E. LINE

\_\_\_\_\_ FT. FROM W. LINE

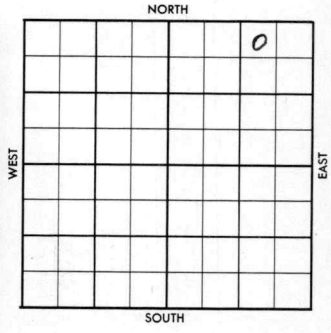

NW NE NE ~~SE~~ - ~~NE~~

1956	ELEVATION 1778'	REPORT
------	--------------------	--------


6-20 Comm. 6-16-56  
8" @200  
Drlg. 1710

7-3 DST 3141-60 op 1 hr., rec. 55' mud,  
800/20".  
DST 3315-30 op 1 hr., 17' mud, BHP 0#  
DST 3315-55 op 1 hr., rec. 40' mud,  
BHP 175/20"  
D & A  
H. 2920'; BL. 3044'; L. 3062';  
Cherty 3325'; S. Sh. 3355', S.Sd.3375'  
A. 3391';  
TD 3400'

**ABANDONED**

County Barton Elev. 11W  
 Sec. 34 Twp. 20S Rge. 11W  
 Company Alpine Oil & Royalty  
 Farm Name Hagen No. 1

TOPS	DEPTH	LOG	DATUM
Anh.			
Tp.			
H.			
Tr.			
Dg.			
Bl.			
L.			
K.C.			
B.K.C.			
Ce.			
C.			
M.			
M.			
K.			
Mz.			
Ma.			
V.			
S.			
S.			
A.			
R.			
Pe.			
G.			
T.D.			

Loc. in Sec. NW NE NE  
DS - NE 1/4  
 Geol. \_\_\_\_\_  
 Contr. Quaker rig #2  
 Pool W.C.  


Date Comm. 6-16-56 JUN 20 '56  
8<sup>th</sup> 200; D 1710

*[Large handwritten scribble]*

APR 5 2 1956

*[Handwritten signature]*

Co.  
Lse.  
No.  
Sec.  
T.  
R.

13

Co.

Sec.

No.

Sec.

T.

R.

County Barton Elev. 1778  
 Sec. 34 Twp. 20S Rge. 11W  
 Company Alpine Oil & Royalty  
 Farm Name Hagen No. 1

TOPS	DEPTH	LOG	DATUM
Anh.			
TP.			
H.	2920		
Tr.			
Dg.			
Bl.	3044		
L.	3062		
K.C.			
B.K.C.			
Ce.			
C. <u>cherty</u>	3325		
M.			
M.			
K.			
Mz.			
Ma.			
V.			
S. <u>sh</u>	3355		
S. <u>sd</u>	3375		
A.	3391		
R.			
PE.			
G.			
TD.	3400		

Loc. in Sec. NW NE NE

DS - NE 1/4

Geol. \_\_\_\_\_  
 Contr. Quaker rig #2

Pool W.C.



Date Comm. 6-16-56 JUL 3 1956

8" 200; D 1710 JUN 27 '56 DST 3141-60

1hr rec 55' Md 800/20'

DST 3315-30 1hr 17' Md

BHP 0 DST 3315-55 1hr

rec 40' Md BHP 175/20

17 3385 JUL 3 '56

D&A