


Section 24 Township 19 Range 3-W

Well No. 1 Bixby

Company Pryor & Lockhart

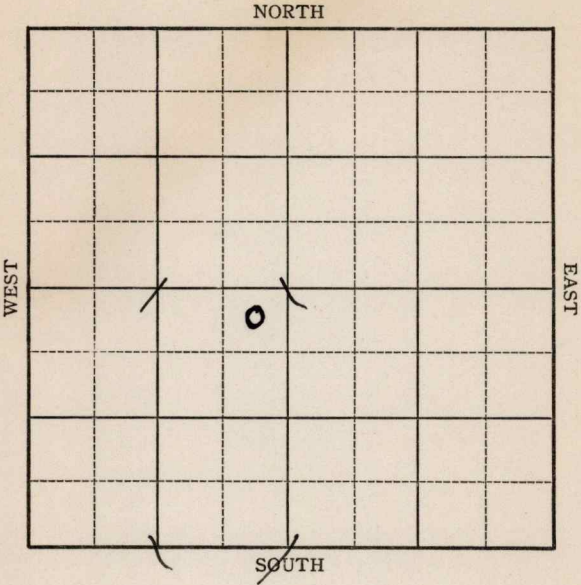

1938

1/12

7" @ 2995'.

Chat 2992'.

T.D. 3017'.

P.B. 3008'.

3000 acid.

Potential 579 bbl s.


No water.

COMPLETED

Map No. 43 Sec. 24 Twp. 19 R. 3WWell No. 1 BixbyPryor & Lockhart

Company

Contractor

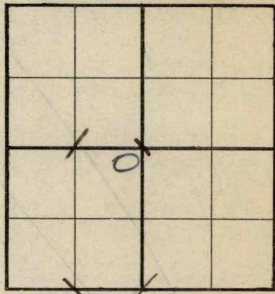FIRST REPORT**NE SW**330 Ft. from N. Line Ft. from S. Line330 Ft. from E. Line Ft. from W. Line**SECTION PLAT**Location Rig up

Drilling and Remarks:

BRR**RECORD**Cased in., ft.Sand Gas Oil Total Depth **PRODUCTION**1st 24 hrs. Nat. 1st 24 hrs. after shot Gas Cu. Ft.Dry Hole Abandoned

Date

DEC 1 - 1937 19H. D. Hatfield Scout

McPherson **KANSAS**Map No. 43 Sec. 24 Twp. 19 R. 3WWell No. 1 BixbyPryor & Lockhart Company

Contractor

COMPLETED

NE SW

330 Ft. from N. Line Ft. from S. Line330 Ft. from E. Line Ft. from W. Line**SECTION PLAT**

	0		

Location Rig up

Drilling and Remarks:

P.B. 3008
3000 acid

POT- 579
no water

RECORDCased 7 in., 2995 ft.Sand Chat 2992Gas Oil Total Depth 3017**PRODUCTION**1st 24 hrs. Nat. 1st 24 hrs. after shot Gas Cu. Ft.Dry Hole Abandoned

Date

JAN 12 1938 19H. D. Hatfield Scout