

KANSAS


FORM 51 5M 6-46 PETROL

Barton County

Section 35 Township 20 Range 11W.

Well No. #3 Mueller

Company Lario O. & Gas

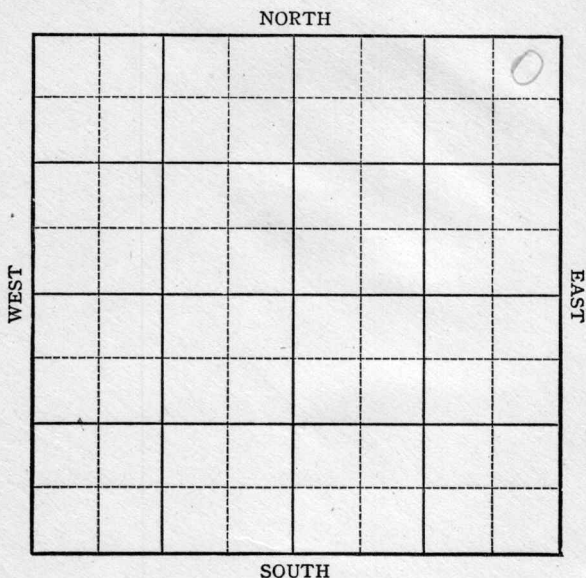

KANSAS

Barton County

Sec. 35 Twp. 20 R. 11W

Well No. #3 Mueller Farm

Lario O. & Gas Company

Snider


330 Ft. from N. Line

Ft. from S. Line

330 Ft. from E. Line

Ft. from W. Line

NE/c

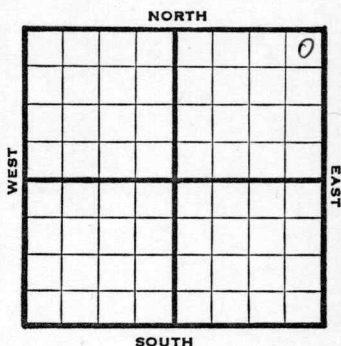

1946

1779

REPORT

7/24 RUR

7/30 8" @ 202
Drlg 2820'

8/6 Arb 3317

TD 3320

5" @ 3319 RUS_t

8/13 TD 3339
200 acid

8/21 Arb. 3317

5" @ 3319

TD 3372'

ABANDONED

Kansas Pool Name SniderKANSAS
Map No. 46 Sec. 35 Twp. 20 R. 11WWell No. 3 MuellerLario O. & Gas

Company

FIRST REPORT

Contractor

NE/C


SECTION PLAT

330 Ft. from N. Line

Ft. from S. Line

330 Ft. from E. Line

Ft. from W. Line

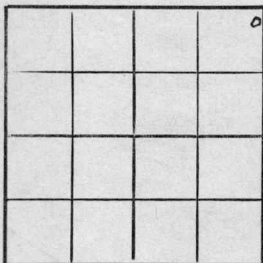

Barton County

Location

Rig up

Drilling and Remarks:

R U R

RECORD

Cased _____ in., _____ ft.

Sand _____

Gas _____

Oil _____

Total Depth _____

PRODUCTION

1st 24 hrs. Nat. _____

1st 24 hrs. after shot _____

Gas _____ Cu. Ft.

Dry Hole _____

Abandoned _____

Date

JUL 24 1946

19

S. J. LEWIS

Scout

KANSAS

Kansas


Pool Name SniderMap No. 46 Sec. 35 Twp. 20 R. 11WWell No. 3 MuellerLario Oil & Gas

Company

ABANDONED

Contractor

NE/C

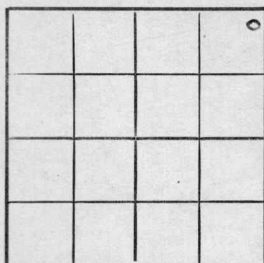E 1, 1779
SECTION PLAT330 Ft. from N. Line Ft. from S. Line330 Ft. from E. Line Ft. from W. LineBarton CountyLocation Rig up

Drilling and Remarks:

OK 3317
5" @ 3319**RECORD**Cased in., ft.Sand Gas Oil Total Depth 3372**PRODUCTION**1st 24 hrs. Nat. 1st 24 hrs. after shot Gas Cu. Ft.Dry Hole Abandoned

Date

AUG 21 1946

19

S. J. LEWIS

Scout