

KANSAS


McPherson

FORM 51 5M 2-38 TPCO.

Section 24 Township 19 Range 3-W

Well No. 1 Carlson

Company Dickey Oil

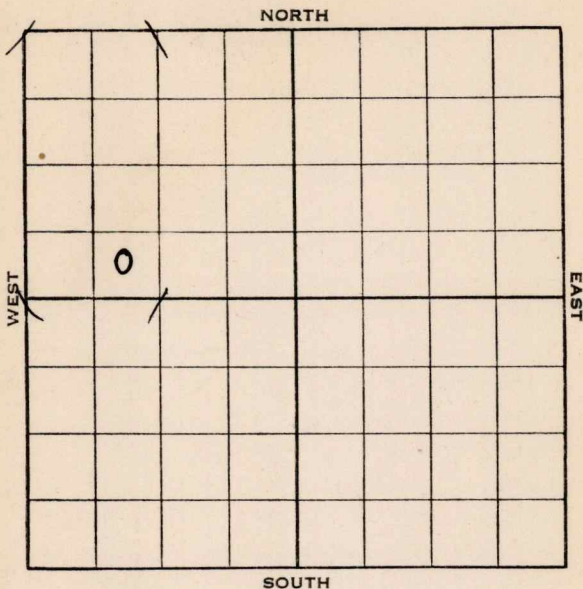

KANSAS


McPherson

Sec. 24 Twp. 19 R. 3-WWell No. #1 Carlson FarmDickey Oil Company

Ft. from N. Line

330 Ft. from S. Line

Ft. from E. Line

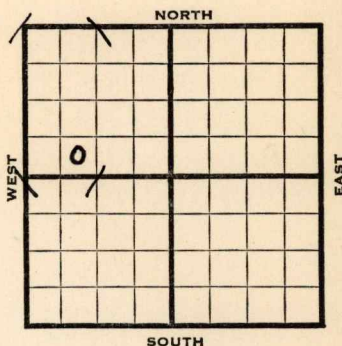990 Ft. from W. LineElev. 1528'.

| 1938  | REPORT                                                                                              |
|-------|---|
| 9/21  | Cellar.                                                                                             |
| 9/30  | "                                                                                                   |
| 10/7  | "                                                                                                   |
| 10/14 | R. R.                                                                                               |
| 10/21 | 10" - 124'. Dlg. 837'.                                                                              |
| 10/28 | Dlg. 1552'.                                                                                         |
| 11/4  | Lans. 2334'. S. O. 2345 -50'.<br>Dlg. 2955'.                                                        |
| 11/12 | Miss. 2978'. 5" - 2980'.<br>T. D. 2989'. 1800' oil 1 hour.<br>Flow 200 oil in 24 hrs.<br>2000 acid. |
| 11/16 | 5" - 2980'.<br>Miss. 2978'.<br>T. D. 2989'.<br>2000 acid.<br>Potential 133 bbls., Pump.             |
|       | COMPLETED                                                                                           |

Map No. 43 Sec. 24 Twp. 19 R. 3WWell No. 1 CarlsonsDickey Oil

Company

Contractor

## FIRST REPORT

SE SW NW


Ft. from N. Line

330 Ft. from S. Line

Ft. from E. Line

990 Ft. from W. Line

## SECTION PLAT

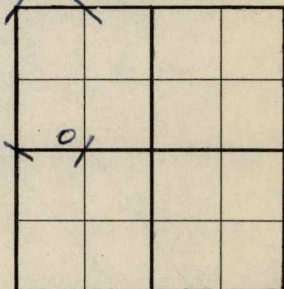

Location \_\_\_\_\_

Rig up \_\_\_\_\_

Drilling and Remarks:

Cellar

## RECORD

Cased \_\_\_\_\_ in., \_\_\_\_\_ ft.

Sand \_\_\_\_\_

Gas \_\_\_\_\_

Oil \_\_\_\_\_

Total Depth \_\_\_\_\_

## PRODUCTION

1st 24 hrs. Nat. \_\_\_\_\_

1st 24 hrs. after shot \_\_\_\_\_

Gas \_\_\_\_\_ Cu. Ft.

Dry Hole \_\_\_\_\_

Abandoned \_\_\_\_\_

Date

SEP 21 193819H. D. HatfieldScout

McPherson

KANSAS

Map No. 43 Sec. 24 Twp. 19 R. 3WWell No. 1 CarlsonDickey Oil

Company

Contractor

COMPLETED

SE SW NW

       Ft. from N. Line330 Ft. from S. Line       Ft. from E. Line990 Ft. from W. Line

## SECTION PLAT

|   |  |  |  |
|---|--|--|--|
|   |  |  |  |
|   |  |  |  |
| 0 |  |  |  |
|   |  |  |  |
|   |  |  |  |

Location                     Rig up                     

Drilling and Remarks:

2000 acidPOT 133Pump

## RECORD

Cased 5 in., 2980 ft.Sand MISS 2978Gas                     Oil                     Total Depth 2989

## PRODUCTION

1st 24 hrs. Nat.                     1st 24 hrs. after shot                     Gas                      Cu. Ft.Dry Hole                     Abandoned                     

Date

NOV 16 1938 19H. D. Hatfield Scout