

Barton

KANSAS

1

20

12W

SECTION \_\_\_\_\_ TOWNSHIP \_\_\_\_\_ RANGE \_\_\_\_\_

#1 Wolf

WELL NO. \_\_\_\_\_

E.K, Edmiston

COMPANY \_\_\_\_\_

NORTH

WEST

EAST

	0						

SOUTH

Barton

KANSAS


SEC.	TWP.	R.
1	20	12W

WELL NO. #1 Wolf FARM

COMPANY E. K. Edmiston

CONTRACTOR ~~SEPT~~ Shelly-Miller Tools  
Chase-Silica

\_\_\_\_\_ FT. FROM N. LINE  
 \_\_\_\_\_ FT. FROM S. LINE  
 \_\_\_\_\_ FT. FROM E. LINE  
 \_\_\_\_\_ FT. FROM W. LINE

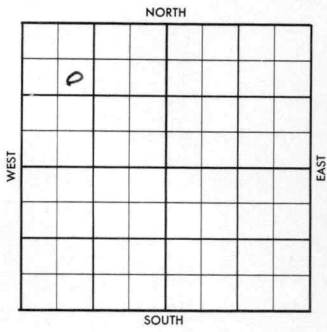

SE NW NW

1956	ELEVATION	REPORT
------	-----------	--------

9-12	Comm 9-5-56 Tops H 2948, Dg 3068, L 3084, A 3346, 8" @ 156 w/150 DST 3087-3150 1 hr 30' mud so, off, DST 3347-58, open 1 hr rec 68' mud so, off, DST 3356-76, 30" 30 ho & gcm, 300 O & gcm, 62' oily mud, Pkr fail NBHP, TD 3376, 5" @ 3356, WOC
------	---

County Barton Elev. \_\_\_\_\_  
 Sec. 1 Twp. 20 Rge. 12W  
 Company E.K. Edmiston  
 Farm Name Wolf No. 1

TOPS	DEPTH	LOG	DATUM	Loc. in Sec.
Anh.				SE NW NW
TP.				
H.	2948			
Tr.				
Dg.				
Bl.	3068			
L.	3084			
K.C.				Geol. _____
B.K.C.				Contr. _____
Ce.				Shelly-Miller
C.				
M.				Tools
M.				Pool
K.				Chase-Silica
Mz.				
Me.				
V.				
S.				
S.				
A	3346			
R.				
PE.				
G.				
T.D.				

SEP 12 '56  
 FIRST REPORT

Date Comm. 9/5/56  
8" @ 156, w/150, DST 3087-3150 1 hr. 30' mud,  
so, 0#, DST 3347-58 open 1 hr. rec. 68' mud,  
so, 0#, DST 3356-76, 30" 30 ho & gcm, 300  
0 & gcm, 62' oily mud, Pkr fail NBHP, TD  
3376, 5" @ 3356, WOC

13

Co.

Use

No.

Sec.

T.

R.

County Barton Elev. 1797  
 Sec. 1 Twp. 20 Rge. 12W  
 Company E. K. Edington  
 Farm Name Wolf No. 1

TOPS	DEPTH	LOG	DATUM	Loc. in Sec.						
Anh.				SE. 1/4 NW						
Tp.										
H.	2918			Geol.						
Tr.										
Dg.				Concr.						
Bl.	3063									
L.	3054			Shelly-Willer tools Pool						
K.C.										
B.K.C.				Chase-Silica						
Ce.										
C.				<table border="1"> <tr> <td></td> <td></td> </tr> <tr> <td>SEP 26 '56</td> <td></td> </tr> <tr> <td></td> <td></td> </tr> </table>			SEP 26 '56			
SEP 26 '56										
M.										
M.				COMPLETE						
K.										
TD.	3376									

Date Comm. 9/3/56

8" @ 156, w/150, DST 3087-3150 1 hr, 30' mud,  
 so, 0#, DST 3347-55 open 1 hr, rec. 68' mud,  
 so, 0#, DST 3356-76, 30" 30 hr & gen, 300  
 0 & gen, 62' oily mud, Pkr fail NBHF, TD

3376, 5" @ 3356, WOC SEP 19 '56 MICT SEP 26 '56

CO 3376 TD 50 g. acid FU 450'  
 oil 12 hrs 1/2. FU 1250' oil  
 12 hrs & 50 Ba no/w in lake  
 1) no inc & 5 Boph no/w POP  
 P. 50 BOPD no/w -