

KANSAS

Form 51—5M—7-40—Palace

Barton

Section 1 Township 20 Range 12-W

Well No. #1 Schartz


Company Alpine et al

Marchand Pool

NORTH

WEST

EAST

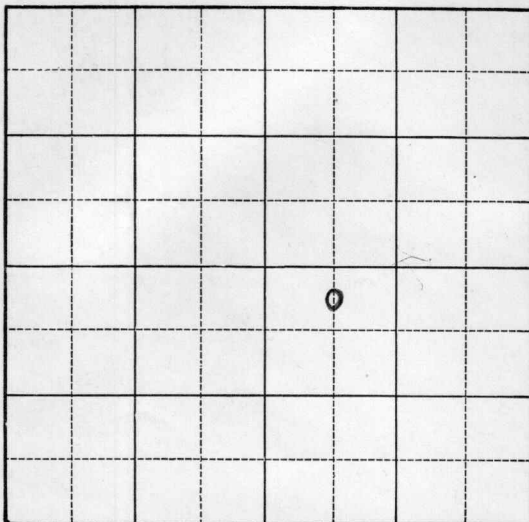

SOUTH

KANSAS

Barton


Sec. 1 Twp. 20 R. 12-WWell No. #1 Schar tz FarmAlpine et al Company
(Marchand)330 Ft. from N. Line

Ft. from S. Line

Ft. from E. Line

660 Ft. from W. Line

Elev. 1792

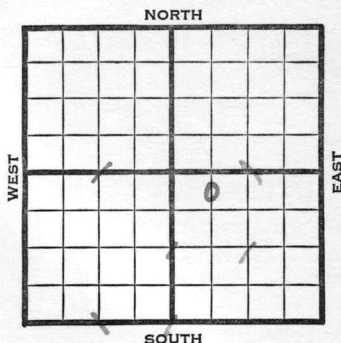

1941

REPORT

3/12

Derrick.

3/20

10" - 250' Anhy 585' Drlg.

3/27

Lams. 3076' Arb. ³³³⁸~~3345~~ 46' T.D.5" - ~~3346~~³³³⁸ RUST.

4/2

Arb. 3338' (Corrected)

5" - 3338' T.D. 3365' 1200' oil

4/10

T.D. 3367' 2500 acid.

1000 Butane.

4/16

Arb. 3338'

T.D. 3367'

1000 acid.

1500 acid.

30 bbls.

39.8 Gravity

COMPLETED

Barton n

Map No. 46 Sec. 1 Twp. 20 R. 12WWell No. 1 SchartzAlpine etal Company

Contractor

FIRST REPORT

SECTION PLAT


330 C N L NW SE
Ft. from N. Line

Ft. from S. Line

Ft. from E. Line

660 Ft. from W. Line

Marchand pool

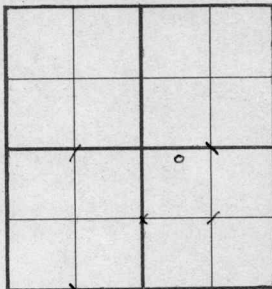

Location _____

Rig up _____

Drilling and Remarks:

Derrick

RECORD

Cased _____ in., _____ ft.

Sand _____

Gas _____

Oil _____

Total Depth _____

PRODUCTION

1st 24 hrs. Nat. _____

1st 24 hrs. after shot _____

Gas _____ Cu. Ft.

Dry Hole _____

Abandoned _____

Date

MAR 12 1941 19

S. J. LEWIS Scout

Map No. 46 Sec. 1 Twp. 20 R. 12WWell No. 1 Schartz

Alpine etal

Company

Contractor

COMPLETED

C N L NW SE

330 Ft. from N. Line Ft. from S. Line Ft. from E. Line660 Ft. from W. Line

MARCHAND POOL

SECTION PLAT

		a	

Location Rig up

Drilling and Remarks:

1000 acid
1500 acid30 bbls.39.8 Bar.**RECORD**Cased in., ft.Sand Sub 3338Gas Oil Total Depth 3367**PRODUCTION**1st 24 hrs. Nat. 1st 24 hrs. after shot Gas Cu. Ft.Dry Hole Abandoned

Date

APR 16 1941

19

S. J. LEWIS

Scout