


Form 51-5M-7-39-Palace

Section 1 Township 20 Range 12-W

Well No. #1 Schartz

Company Alpine Oil & Royalty

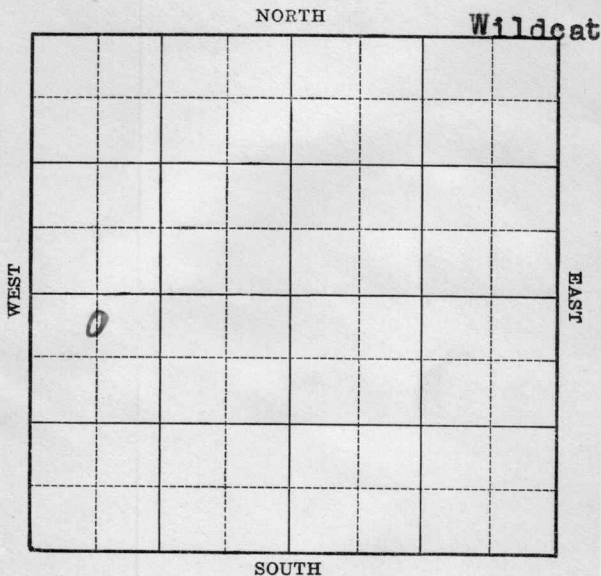

KANSAS

Barton

Sec. 21 Twp. 20 R. 12-WWell No. #1 Schartz FarmAlpine Oil & Royalty Company

(Wildcat)

~~660~~ 330

Ft. from N. Line

Ft. from S. Line


~~330~~

Ft. from E. Line

660

Ft. from W. Line

Elev. 1794

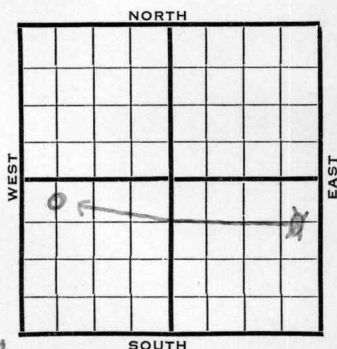

1940

REPORT

5/1 Location

5/9 Surface hole.

5/16 13" - 200' Anhy 550'

Drlg. 2630'

5/22 Arb. 3344'

T.D. 3386'

Water.

ABANDONED

Map No. _____ Sec. 2 Twp. 20 R. 12WWell No. 1 ScharitzAlpine Oil & Royalty Company

Contractor _____

FIRST REPORT

SECTION PLAT

C $E\frac{1}{2}$ NE SE660 Ft. from N. Line

_____ Ft. from S. Line

330 Ft. from E. Line

_____ Ft. from W. Line

			o

WILDCAT

Location X

Rig up _____

Drilling and Remarks:

RECORD

Cased _____ in., _____ ft.

Sand _____

Gas _____

Oil _____

Total Depth _____

PRODUCTION

1st 24 hrs. Nat. _____

1st 24 hrs. after shot _____

Gas _____ Cu. Ft.

Dry Hole _____

Abandoned _____

Date

MAY 1 1940₁₉

S. J. LEWIS

Scout

Map No. 46 Sec. 1 Twp. 20 R. 12WWell No. 1 ScharitzAlpine Oil & Royalty

Company

CORRECTIONS

Contractor

SECTION PLAT

o			

C N L NW SW

330 Ft. from N. Line

Ft. from S. Line

Ft. from E. Line

660 Ft. from W. Line

WILDCAT

Location _____

Rig up _____

Drilling and Remarks:

Reported

C E L NE SE

2-20-12W

RECORD

Cased _____ in., _____ ft.

Sand _____

Gas _____

Oil _____

Total Depth _____

PRODUCTION

1st 24 hrs. Nat. _____

1st 24 hrs. after shot _____

Gas _____ Cu. Ft.

Dry Hole _____

Abandoned _____

Date

MAY 2 1940 19

S. J. LEWIS

Scout

Map No. 46 Sec. 1 Twp. 20 R. 12^WWell No. 1 SchartzAlpine Oil & Royalty Company

Contractor _____

ABANDONED

C N L NW SW

330 Ft. from N. Line

_____ Ft. from S. Line

_____ Ft. from E. Line

660 Ft. from W. Line

WILDCAT

SECTION PLAT

o			

Location _____

Rig up _____

Drilling and Remarks:

*Cr 83344**Water.*

RECORD

Cased _____ in., _____ ft.

Sand _____

Gas _____

Oil _____

Total Depth 3386

PRODUCTION

1st 24 hrs. Nat. _____

1st 24 hrs. after shot _____

Gas _____ Cu. Ft.

Dry Hole _____

Abandoned _____

Date

MAY 22 1940

19

S. J. LEWIS

Scout