


McPherson

Form 51-5M-11-31-Palace

Map No. **KANSAS** Sec. *35* Twp. *19* R. *3w*

Well No. *1-Wellstrom* Farm
Shell Oil Co Company

NORTH

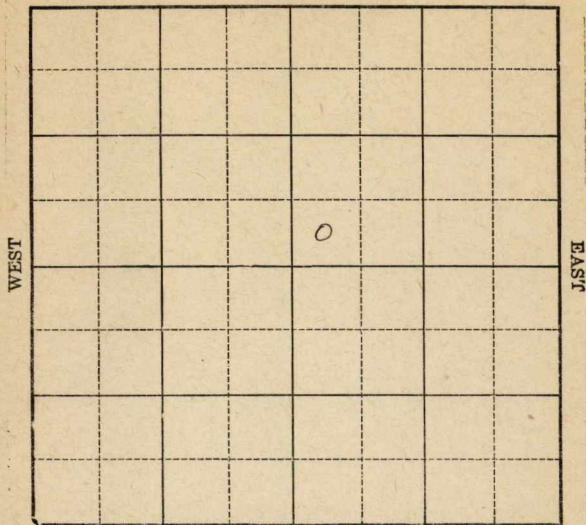

SOUTH

Location _____

Drilling Remarks _____

Rig Up _____

Drilling Remarks _____

RECORD

Cased _____ in. _____ ft.

Sand _____

Gas _____

Oil _____

Total Depth _____

PRODUCTION

1st 24 hrs. Nat. _____

1st 24 hrs. after shot _____

Gas _____ cu. ft.

Dry Hole _____

Abandoned _____

Map No. **KANSAS** Sec. 35 Twp. 19 R. 3^w


Well No. 1- Helstrom Farm
Shell Pet Company

_____ Ft. from N. Line

330 Ft. from S. Line

_____ Ft. from E. Line

330 Ft. from W. Line
1932

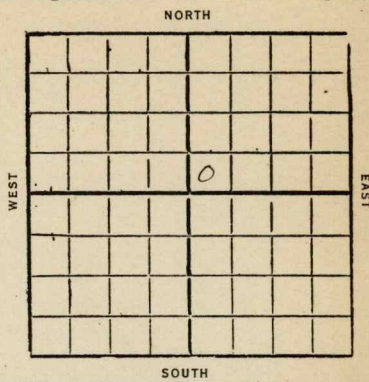

Date	REPORT
2/10	Loc
2/17	Pegway
2/26	Dredg
3/2	Dredg 1850'
3/9	7" 2650'
3/16	Top Chat 2988
3/22	T.D. 2991' Rust
3/30	8"-2991
	First gas 2991
	Had 3,482,000 cubic feet gas at 3013
	First oil at 3017
	T.D. 3020
	Est 200 bbls oil and 5 M gas
	895# R.P.
4/6	T.D. 3051
	Made 210 bbl 5 1/4 hours and (est) 5 1/2 M gas
	(over)

4/13- TD 3051

Est 5 1/2 ft gas and
17 1/2 bbl oil per hour
400# back pressure

4/20- Cased 8"-2991

Chat 2988-3051

First gas 2991

" oil 3017

TD 3051

Mkg 17 1/2 bbl per hr
and 5 1/2 ft gas
Comp.

M. Pherson

43 **KANSAS** Sec. 35 Twp. 19 R. 3^W

Well No. 1 *Helstrom*

Shelley pet Co

Company

Contractor

FIRST REPORTS

SECTION PLAT

_____ Ft. from N. Line

330 Ft. from S. Line

_____ Ft. from E. Line

330 Ft. from W. Line

		0	

Location

RECORD

Cased _____ in., _____ ft.

Sand _____

Gas _____

Oil _____

Total Depth _____

Rig up _____

Drilling and Remarks:

PRODUCTION

1st 24 hrs. Nat. _____

1st 24 hrs. after shot _____

Gas _____ Cu. Ft.

Dry Hole _____

Abandoned _____

Date

FEB 1 0 1932

19

CHAS. L. SHERWOOD

Scout

McPherson

W

43 **KANSAS** Map No. Sec. *35* Twp. *19* R. *3*

Well No. *1 Helstrom*

Shell Jet Co Company

Contractor

COMPLETED

SECTION PLAT

..... Ft. from N. Line

330 Ft. from S. Line

..... Ft. from E. Line

330 Ft. from W. Line

Location.....

Rig up.....

Drilling and Remarks:

187 gas 2991

187 Oil 3017

17 1/2 Bls Oil

Per Hour

RECORD

Cased *8* in., *2991* ft.

Sand *@ 2988-3051*

Gas.....

Oil.....

Total Depth *3051*

PRODUCTION

1st 24 hrs. Nat.....

1st 24 hrs. after shot.....

Gas *5 1/2* ~~*4*~~ Cu. Ft.

Dry Hole.....

Abandoned.....

Date

APR 20 1932 CHAS. L. SHERWOOD

192..... Scout