

**KANSAS**


McPherson

Section 35 Township 19 Range 3W

Well No. 1 Johnson "B"

Company Casebeer

**Lindsborg**  
NORTH

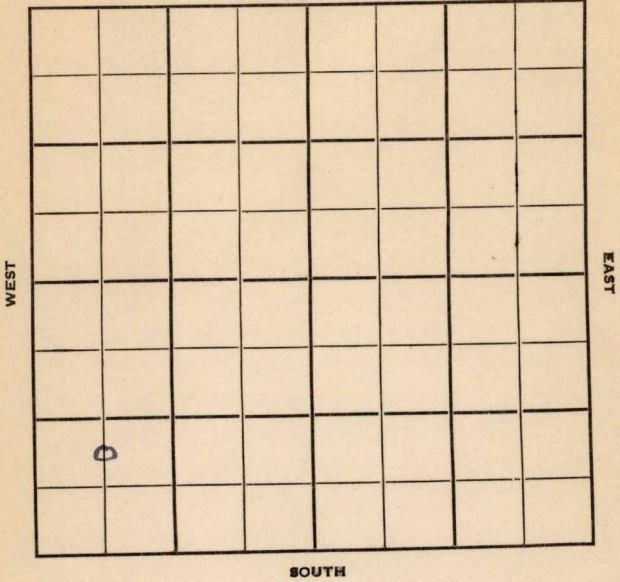

# KANSAS

McPherson ✓

Sec. 35 Twp. 19 R. 3W

Well No. 1 Johnson "B" Farm \_\_\_\_\_

Casebeer Company \_\_\_\_\_

Lindsborg Pool


Uhl Drlg. - Contr.

\_\_\_\_\_ Ft. from N. Line

990 Ft. from S. Line

\_\_\_\_\_ Ft. from E. Line

660 Ft. from W. Line

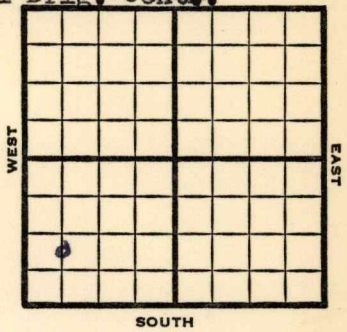

C N L SW SW

1949 **Elev. 1501'** REPORT

- 9/28 RUR
- 10/5 8" @ 208'  
Drlg 1580'
- 10/12 **KC 2348'**  
Drlg 2780'
- 10/19 **Miss 2982'**  
TD 3004'  
5" @ 3003'
- 10/26 TD 3045'  
Acid 2000
- 11/2 TD 3045'  
**Miss 2982'**  
5" @ 3003'  
2000 acid  
Pump 50 Oil / 50 W Pot  
38° Gr.  
Comp

**COMPLETED**

Kansas

Map No. \_\_\_\_\_ Sec. 35 Twp. 19 R. 3 W

Well No. 1 Johnson "B"

Casebeer Company

Uhl Drlg. Contractor

C N L S W S W

FIRST REPORT SECTION PLAT

\_\_\_\_\_ Ft. from N. Line

990 Ft. from S. Line

\_\_\_\_\_ Ft. from E. Line

660 Ft. from W. Line


McPherson County

Location \_\_\_\_\_

Rig up \_\_\_\_\_

Drilling and Remarks:

R U R

RECORD

Cased \_\_\_\_\_ in., \_\_\_\_\_ ft.

Sand \_\_\_\_\_

Gas \_\_\_\_\_

Oil \_\_\_\_\_

Total Depth \_\_\_\_\_

PRODUCTION

1st 24 hrs. Nat. \_\_\_\_\_

1st 24 hrs. after shot \_\_\_\_\_

Gas \_\_\_\_\_ Cu. Ft.

Dry Hole \_\_\_\_\_

Abandoned \_\_\_\_\_

Date

SEP 28 1949 19

S. J. LEWIS Scout

Map No. \_\_\_\_\_ Sec. 35 Twp. 19 R. 3W

Well No. 1 Johnson "B"

Casebeer \_\_\_\_\_ Company

COMPLETE \_\_\_\_\_ Contractor

C N L SW SW

E1, 1501  
SECTION PLAT

o			

\_\_\_\_\_ Ft. from N. Line

990 Ft. from S. Line

\_\_\_\_\_ Ft. from E. Line

660 Ft. from W. Line

McPherson County

Location \_\_\_\_\_

Rig up \_\_\_\_\_

Drilling and Remarks:

*Misc 2882  
5" @ 3003  
2000 acid  
Pump 55 oil 100 W  
P.T.*

RECORD

Cased \_\_\_\_\_ in., \_\_\_\_\_ ft.

Sand \_\_\_\_\_

Gas \_\_\_\_\_

Oil \_\_\_\_\_

Total Depth 8045

PRODUCTION

1st 24 hrs. Nat. \_\_\_\_\_

1st 24 hrs. after shot \_\_\_\_\_

Gas \_\_\_\_\_ Cu. Ft.

Dry Hole \_\_\_\_\_

Abandoned \_\_\_\_\_

Date

NOV 2 1949 19

S. J. LEWIS Scout