

SECTION 36 TOWNSHIP 19 RANGE 3 W

WELL NO. #1 Kaufman

COMPANY Frank G. Wood

NORTH

WEST

EAST

SOUTH

McPherson

KANSAS

SEC.	TWP.	R.
36	19	3W


WELL NO. #1 Kaufman FARM

COMPANY Frank H. Wood

CONTRACTOR Bedell & Catt

Semi Wildcat

_____ Ft. from N. Line
 _____ Ft. from S. Line
 _____ Ft. from E. Line
 _____ Ft. from W. Line

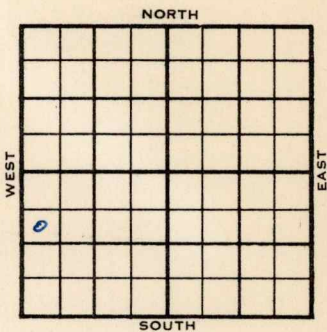

SW NW SW

1955	ELEVATION	REPORT
	1515'	

10/26 Comm 10-20-55
 8" @ 147/115
 Drlg 1549

11/2 Comm 10-20-55
 8" @ 147/115

- H 2156
- L 2403
- BKC 2786
- Ce 2944
- M 3053
- TD 3084
- D & A

ABANDONED

County **McPherson** Elev. _____
 Sec. **36** Twp. **19** Rge. **3W**
 Company **Frank G. Wood**
 Farm Name **Kaufman** No. **1**

TOPS	DEPTH	LOG	DATUM
Anh.			
T.P.			
H.			
Tr.			
Dg.			
Bl.			
L.			
K.C.			
B.K.C.			
Ce.			
C.			
M.			
M.			
K.			
Mz.			
Mq.			
V.			
S.			
S.			
A			
R.			
PE.			
G.			
T.D.			

Loc. in Sec. **SW NW SW**
 Geol. _____
 Contr. **Bedell & Catb**
 Pool **Semi Wildcat**
 FIRST REPORT
 OCT 26 '55

Date Comm. **10-20-55**
8" @ 147/115 drlg. 1549

Co.
No.
Sec.
T.
R.

County McPherson Elev. 1515
 Sec. 36 Twp. 19 Rge. 3W
 Company Frank G. Wood
 Farm Name Kaufman No. 1

TOPS	DEPTH	LOG	DATUM
Anh.			
TP.			
H.	<u>2156</u>		<u>641</u>
Tr.			
Dg.			
Bl.			
L.	<u>2403</u>		<u>888</u>
K.C.			
B.K.C.	<u>2786</u>		<u>1271</u>
Ce.	<u>2944</u>		<u>1429</u>
C.			
M.	<u>3053</u>		<u>1538</u>
M.			
K.			
Mz.			
Mq.			
V.			
S.			
S.			
A.			
R.			
PE.			
G.			
T.D.	<u>3084</u>		

Loc. in Sec. SW NW SW
 Geol. _____
 Contr. Bedell & Cat
 Pool Semi Wildcat



Date Comm. 10-20-55 NOV 2 1955
8" @ 147/115

D & A

Co.
 No.
 Sec.
 T.
 R.