

McPherson


Form 51-5M-11-31-Palace

Map No. **KANSAS** Sec. 35 Twp. 19 R. 3<sup>w</sup>

Well No. 5-4563 Farm

Oruntz Oil & Gas Co. Company

NORTH

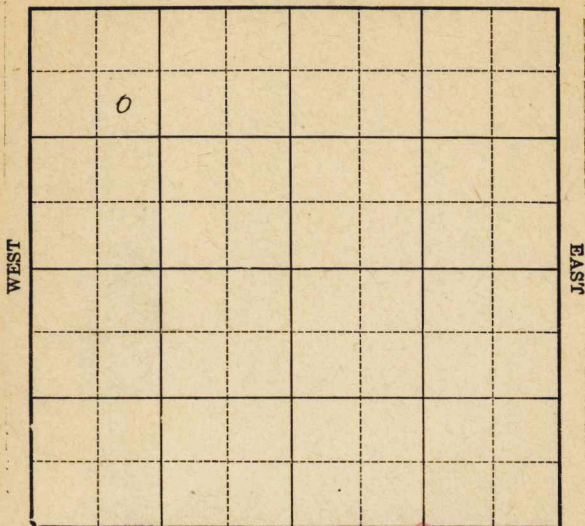

Location

Drilling Remarks

Rig Up

Drilling Remarks

RECORD

Cased in. ft.

Sand

Gas

Oil

Total Depth

PRODUCTION

1st 24 hrs. Nat.

1st 24 hrs. after shot

Gas cu. ft.

Dry Hole

Abandoned

Map No. **KANSAS** Sec. 35 Twp. 19 R. 3<sup>w</sup>

Well No. 1-Casey Farm  
L. H. Crumley Dreg Company

NORTH


990 Ft. from N. Line

\_\_\_\_\_ Ft. from S. Line

\_\_\_\_\_ Ft. from E. Line

990 Ft. from W. Line

1932

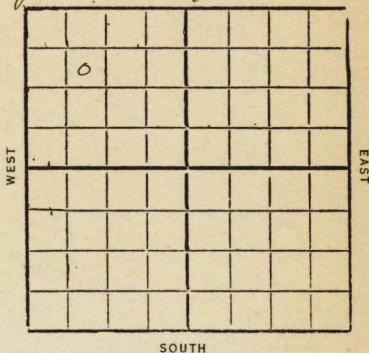

Date

REPORT

|      |                                                       |
|------|-------------------------------------------------------|
| 4/13 | Rotary rig                                            |
| 4/20 | 15"-224'                                              |
| 4/27 | 12"-224'                                              |
|      | Dreg 1890'                                            |
| 5/4  | 7" 2510'                                              |
| 5/11 | Top Chat 2988'                                        |
|      | Cem 8"-2990'                                          |
|      | SD 2992'                                              |
| 5/18 | T.D. 3050'                                            |
|      | Est 3 ft gas and<br>15 to 20 bbls per hour<br>shut in |
| 5/25 | —                                                     |
| 6/1  | T.D. 3050' No test                                    |
| 6/8  | —                                                     |
| 6/15 | —                                                     |
| 6/22 | —                                                     |
| 6/29 | —                                                     |
| 7/6  | —                                                     |
| 7/13 | —                                                     |
| 7/20 | —                                                     |
| 7/27 | —                                                     |



8/3. Chat 2988-3050  
TD 3050  
Shut in to 50 bbl day  
3# gas  
Comp.

1933

2/22- Old TD 3050'  
Will dupen!

3/1- Chat 2988-3098

T. D. 3098

Est 125 bbls 24 hours

Est 6 M GAS

(Comp)

McPherson

43 KANSAS

Map No. \_\_\_\_\_ Sec. 35 Twp. 19 R. 3<sup>W</sup>

Well No. 1 Kasey

L. W. Prunty Oil Co. Company

Contractor

## FIRST REPORTS


990 Ft. from N. Line

\_\_\_\_\_ Ft. from S. Line

\_\_\_\_\_ Ft. from E. Line

990 Ft. from W. Line

## SECTION PLAT

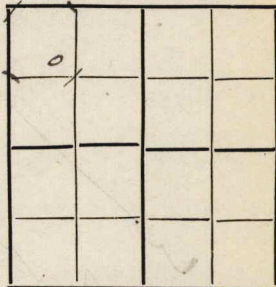

Location \_\_\_\_\_

Rig up Rotary Rig

Drilling and Remarks:

## RECORD

Cased \_\_\_\_\_ in., \_\_\_\_\_ ft.

Sand \_\_\_\_\_

Gas \_\_\_\_\_

Oil \_\_\_\_\_

Total Depth \_\_\_\_\_

## PRODUCTION

1st 24 hrs. Nat. \_\_\_\_\_

1st 24 hrs. after shot \_\_\_\_\_

Gas \_\_\_\_\_ Cu. Ft.

Dry Hole \_\_\_\_\_

Abandoned \_\_\_\_\_

Date

APR 13 1932 CHAS. L. SHERWOOD

192

Scout



McPherson

43

KANSAS

Map No. \_\_\_\_\_ Sec. 35 Twp. 19 R. 3<sup>W</sup>

Well No. 1 Kasey

L. N. Prunty Oil Co. Company

Contractor

COMPLETED

## SECTION PLAT

|   |  |  |  |
|---|--|--|--|
|   |  |  |  |
| 0 |  |  |  |
|   |  |  |  |
|   |  |  |  |
|   |  |  |  |

990 Ft. from N. Line

\_\_\_\_\_ Ft. from S. Line

\_\_\_\_\_ Ft. from E. Line

990 Ft. from W. Line

Location \_\_\_\_\_

Rig up \_\_\_\_\_

Drilling and Remarks:

Shut in to  
50 Bls per day

## RECORD

Cased \_\_\_\_\_ in., \_\_\_\_\_ ft.

Sand \_\_\_\_\_

Gas \_\_\_\_\_

Oil \_\_\_\_\_

Total Depth 3050

## PRODUCTION

1st 24 hrs. Nat. \_\_\_\_\_

1st 24 hrs. after shot \_\_\_\_\_

Gas 3 AT \_\_\_\_\_ Cu. Ft.

Dry Hole \_\_\_\_\_

Abandoned \_\_\_\_\_

Date

AUG 3 1932 CHAS. L. SHERWOOD

192

Scout

43 KANSAS

Map No. \_\_\_\_\_ Sec. 35 Twp. 19 R. 3<sup>W</sup>

Well No. 1 Kasey

L. N. Phuntz Bldg Co Company

Contractor

## FIRST REPORTS


990 Ft. from N. Line

\_\_\_\_\_ Ft. from S. Line

\_\_\_\_\_ Ft. from E. Line

990 Ft. from W. Line

## SECTION PLAT

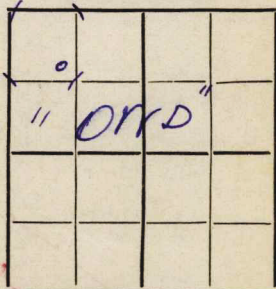

Location \_\_\_\_\_

Rig up \_\_\_\_\_

Drilling and Remarks:

Will Drill  
Deeper

## RECORD

Cased \_\_\_\_\_ in., \_\_\_\_\_ ft.

Sand \_\_\_\_\_ Hat 2988-3050

Gas \_\_\_\_\_

Oil \_\_\_\_\_

Total Depth 3050

## PRODUCTION

1st 24 hrs. Nat. \_\_\_\_\_

1st 24 hrs. after shot \_\_\_\_\_

Gas \_\_\_\_\_ Cu. Ft.

Dry Hole \_\_\_\_\_

Abandoned \_\_\_\_\_

Date

FEB 22 1933

CHAS. L. SHERWOOD

192

Scout

43 **KANSAS** Map No. \_\_\_\_\_ Sec. 35 Twp. 19 R. 3<sup>w</sup>

Well No. 1 Hasey

L. N. Prunty Bly Co Company

Contractor

## SECTION PLAT


**COMPLETED**

990 Ft. from N. Line

\_\_\_\_\_ Ft. from S. Line

\_\_\_\_\_ Ft. from E. Line

990 Ft. from W. Line

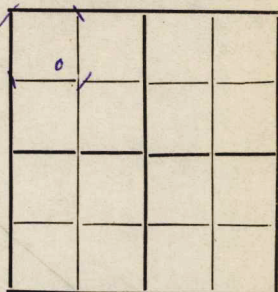

Location \_\_\_\_\_

Rig up \_\_\_\_\_

Drilling and Remarks:

est 125 Bed  
24 hours

**RECORD**

Cased Lat 2988-3098 in., \_\_\_\_\_ ft.  
Sand \_\_\_\_\_  
Gas \_\_\_\_\_  
Oil \_\_\_\_\_  
Total Depth 3098

**PRODUCTION**

1st 24 hrs. Nat. \_\_\_\_\_  
1st 24 hrs. after shot \_\_\_\_\_  
Gas est 6 m Cu. Ft.  
Dry Hole \_\_\_\_\_  
Abandoned \_\_\_\_\_

Date

**MAR 1 1933**

192

**CHAS. L. SHERWOOD**

Scout