

KANSAS

Barton


Section 6 Township 20 Range 12W

Well No. 1 Fransen

Company Mouser Drlg.

Wildcat

NORTH

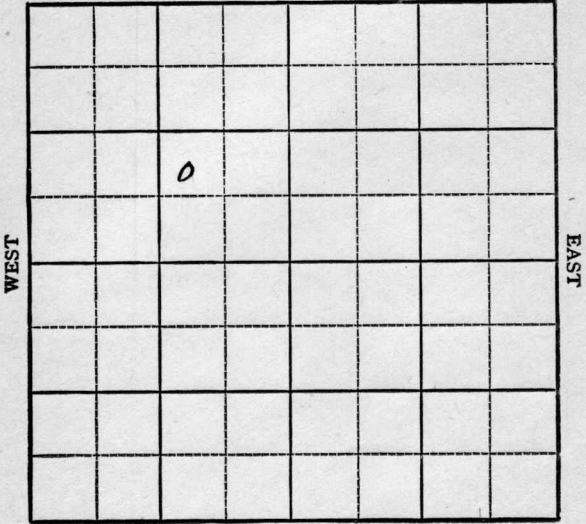

SOUTH

KANSAS

Barton

Sec. 6 Twp. 20 R. 12W

Well No. #1 Fransen Farm

Mouser Drlg. Company


Wildcat

\_\_\_\_\_ Ft. from N. Line

990' \_\_\_\_\_ Ft. from S. Line

990' \_\_\_\_\_ Ft. from E. Line

\_\_\_\_\_ Ft. from W. Line

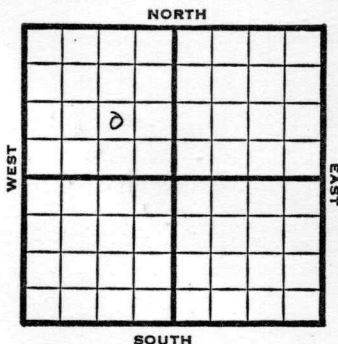

NW SE NW

SOUTH

1948

Level 1828'

REPORT

12/8 8" @ 316'

12/15 Drlg. 2875'

12/22 Lansing 3162'  
Arbuckle 3452'  
TD 3461'  
5" @ 3250'

12/29 "

1/4 21 shots @ 3170-80'  
2000 acid  
Pump 6 bbl oil PH for 6 hr

1/12 "

1/19 48 shots 3196-3206  
1000 acid  
Pump 5 oil PH 8 hrs.

1/26 "

2/2 "

2/9 "

2/16 "

2/23 "

3/2 "

3/8 "

3/16 "

3/23 "

3/30 "

4/6 "

4/12 "

4/20 "

OVER

1949

4/27 Pump 5 Oil PH 8 hrs.

5/4 "

5/10 "

5/18 "

5/25 "

6/1 TD 3461'

Arb. 3452'

5"@ 3250'

Aband.

**ABANDONED**

Map No. \_\_\_\_\_ Sec. 6 Twp. 20 R. 12W

Well No. 1 Fransen

Mouser Drlg. \_\_\_\_\_ Company

FIRST REPORT \_\_\_\_\_ Contractor

NW SE NW

**SECTION PLAT**

\_\_\_\_\_ Ft. from N. Line

990 Ft. from S. Line

990 Ft. from E. Line

\_\_\_\_\_ Ft. from W. Line

	o		

Barton County

Location \_\_\_\_\_

Rig up \_\_\_\_\_

Drilling and Remarks:

8" @ 316

**RECORD**

Cased \_\_\_\_\_ in., \_\_\_\_\_ ft.

Sand \_\_\_\_\_

Gas \_\_\_\_\_

Oil \_\_\_\_\_

Total Depth \_\_\_\_\_

**PRODUCTION**

1st 24 hrs. Nat. \_\_\_\_\_

1st 24 hrs. after shot \_\_\_\_\_

Gas \_\_\_\_\_ Cu. Ft.

Dry Hole \_\_\_\_\_

Abandoned \_\_\_\_\_

Date

DEC 8 1948 19

S. J. LEWIS Scout

