

Company Morrison Drlg.

WEST

EAST

SOUTH

SEC.	TWP.	R.
10	20	18W ✓

WELL NO.

#1 Vaugh

FARM

COMPANY

Morrison Drlg.

CONTRACTOR

Morrison Drlg.

Wildcat


330 Ft. from N. Line

Ft. from S. Line

Ft. from E. Line

330 Ft. from W. Line

NW NW NW

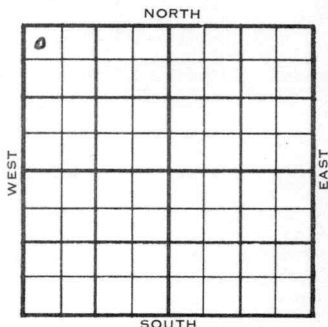

Phillips - DHM

	ELEVATION	REPORT
1954	2165'	

3/10 Spud 3-5-54
8" @ 281'
Anhy 1256'
Drlg 1275'

3/17 KC 3627'
Drlg. 3662'

3/24 Spud 3-5-54 D & A TD 4079
8" @ 281' Anhy 1256' KC 3627
B KC 3918 Marm 3928 Arb. 4037
DST 4020-79 open 1½ hr rec 180' wtr.
300' WCM 950# TD 4079
D & A

ABANDONED

County **Pawnee** State **Kansas**Sec. **10** (Blk.) **20** (Sur.) **18W** Map No.Operator **Morrison Drlg.**Well No. **1** Farm **Vaugh**Elev. Location **NW NW NW**

0							


FIRST REPORT

330 Ft. From **N** Line **NW****330** Ft. From **W** Line Quarter1st. Report **MAR 1 0 1954**

Completion

Remarks **Phillips - IHM**
Morrison Drlg. - Contr.Spudding Date **3-5-54**Drlg. Data **Wildcat****8" @ 281 Anhy 1256 drlg. 1275**

J. G. McGEHEE

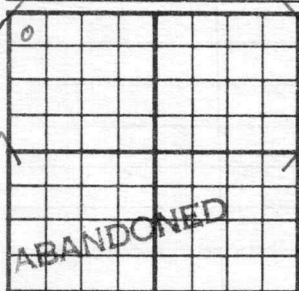County Pawnee State KansasSec. 10 (Blk.
Twp.) 20 (Sur.
Rge.) 18W Map No.Operator Morrison Drlg.Well No. 1 Farm VaughElev. 2165 Location NW NW NW330 Ft. From N Line NW330 Ft. From W Line Quarter

1st. Report

Completion MAR 24 1954Remarks WildcatMorrison Drlg. - Contr.Spudding Date 3-5-54Drlg. Data D & A TD 40798" @ 281 Anhy 1256 KC 3627B KC 3918 Marm. 3928 Arb. 4037DST 4020-79 open 1½ hr. Rec. 180' wtr.300' wcm 950# TD 4079D & A