Barton


KANSAS

SECTION 5 TOWNSHIP 20 RANGE 12W

WELL NO. #2 Lanterman "C"

COMPANY Bea Drlg.

NW SE SE

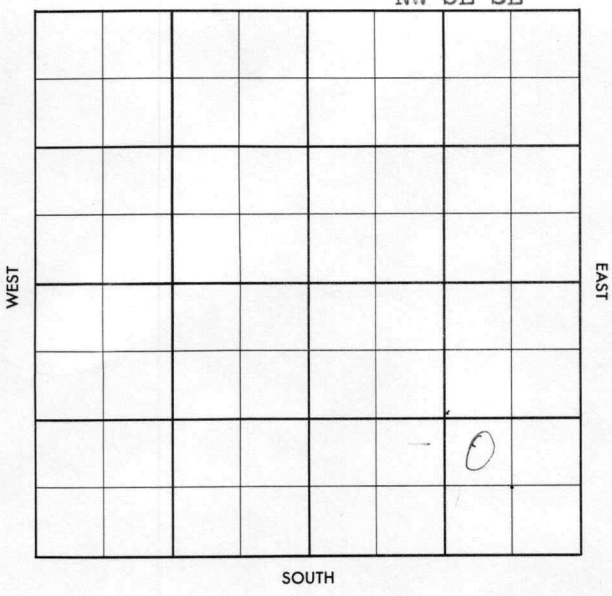

FORM 504-3 SUNRAY

FORM 513 SUNRAY

County Barton Elev.

Sec. 5 Twp. 20 Rge. 12W

Company Bea Drlg.

Farm Name Lanterman "C" No. 2

TOPS	DEPTH	LOG	DATUM
Anh.			
Tp.			
H.			
Tr.			
Dg.			
Bl.			
L.			
K.C.			
B.K.C.			
Ce.			
C.			
M.			
M.			
K.			
Mz.			
Mo.			
V.			
S.			
S.			
A			
R.			
P€.			
G.			
T.D.			

Loc. in Sec. NW SE SE

Geol.

Contr. Co. tools

Pool NE Sunny Valle

FIRST REPORT

JAN 23 57

Date Comm. 3-19-57

8" @ 200 drlg. 1800

Co. Lse. No. Sec. T. R.

FORM 513 SUNRAY

County Barton Elev. 1823

Sec. 5 Twp. 20 Rge. 12W

Company Bea Drlg.

Farm Name Lanterman "C" No. 2

TOPS	DEPTH	LOG	DATUM
Anh.			
Tp.			
H.	3023		
Tr.			
Dg.			
B.L.	3138		
L.	3155		
K.C.			
B.K.C.			
Ce.			
C.			
M.			
M.			
K.			
Mz.			
Mc.			
V.			
S.			
S.			
A	3418		
R.			
P€.			
G.			
T.D.	3485		

Loc. in Sec. NW SE SE

Geol.

Contr. Co. tools

Pool NE Sunny Valle

JAN 30 '57

ABANDONED

0

Date Comm. 1-19-57

8" @ 200 drlg. 1800 JAN 30 '57 DST

3428-38 op. 30" rec 7' Md

BHP 420/15"

DEA

Co. Lse. No. Sec. T. R.