
FORM 51

Barton KANSAS

Section 5 Township 20 Range 12W

Well No. 1 Steckel

Company Lion Oil

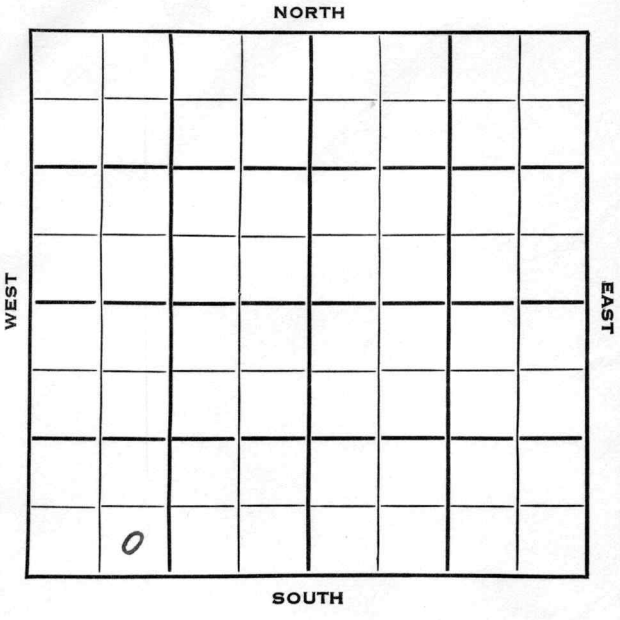

Barton KANSAS

| SEC. | TWP. | R. |
|---|---|---|
| 5 | 20 | 12W |

WELL NO. #1 Steckel FARM

COMPANY Lion Oil

CONTRACTOR Garvey

NE Sunny Valley Pool


_____ Ft. from N. Line

330 Ft. from S. Line

_____ Ft. from E. Line

990 Ft. from W. Line

SE SW SW

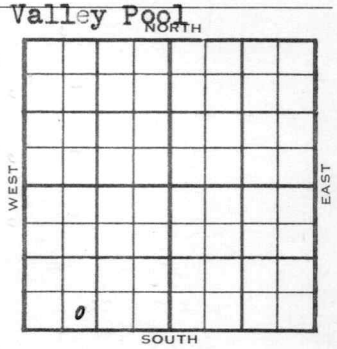


1954 ELEVATION 1827' REPORT

3/24 Spud 3-21-54
Drlg 237'

3/31 8" @ 244' w/200 sks
Anhy 647', Heeb 3024', Tor 3040'
Br. L. 3138', Lans 3154'
DST 3140'-75' ½ hr, 5' M 0#
DST 3204'-30' 1 hr, 6' M 0#
DST 3235'-48' 1 hr, 33' M 1000#
Arb 3395'

4/7 Ø 3401-03', 2' dol
RTD 3403' Schl
5" @ 3396'
DD 3411', 1000A
B/25 goph 4 hrs., 2000A, Sq.

OVER

DX-78

1954
5/5 Spud 3-21-54
Oil Well
TD 3411'
8" @ 244'
Anhy 647', Heeb 3024', Tor 3040',
Br lime 3138', Lans 3154'
DST 3140-75', opn ½ hrs., rec. 5'
mud, 0#
DST 3204-30', opn 1 hr., rec.6' mud,
0#
DST 3235-48', opn 1 hr., rec. 33' mud,
1000#
Arb. 3395'
TD 3403'
5" @ 3396'
DD 3411', 1000A
B/25 goph 4 hrs.
2000A
CO to 3411'
B/11 goph 500A
S/1½ boph 6 hrs., 1000A
S/3 boph 8 hrs.
P/2½ boph
Comp. 118 bopd

COMPLETED

FORM 275 FOR SALE BY KANSAS BLUE PRINT CO.


County Barton State Kansas

Sec. 5 (Blk. Twp.) 20 (Sur. Rge.) 12W Map No.

Operator Lion Oil

Well No. 1 Farm Steckel

Elev. Location SE SW SW

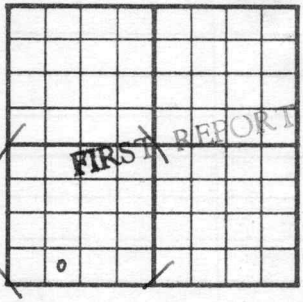


330 Ft. From S Line SW

990 Ft. From W Line Quarter

1st. Report MAR 2 4 1954

Completion

Remarks

Garvey - Contr.

Spudding Date 3-21-54

Drlg. Data NE Sunny Valley Pool

drlg. 237

J. G. McGEHEE

FORM 275 FOR SALE BY KANSAS BLUE PRINT CO.


County Barton State Kansas

Sec. 5 (Blk. Twp.) 20 (Sur. Rge.) 12W Map No.

Operator Lion Oil

Well No. 1 Farm Steckel

Elev. 1827 Location SE SW SW

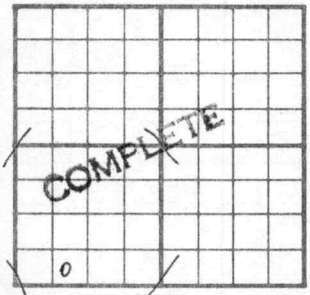


330 Ft. From S Line SW

990 Ft. From W Line Quarter

1st. Report

Completion MAY 5 1954

Remarks NE Sunny Valley Pool

Garvey - Contr.

Spudding Date 3-21-54

Drlg. Data Oil well TD 3411

8" @ 244 Anhy 647 Heeb. 3024

Tor. 3040 Br. lime 3138 Lans. 3154

DST 3140-75 open ½ hr. Rec. 5' mud

0# DST 3204-30 open 1 hr. Rec. 6' mud

0# DST 3235-48 open 1 hr. Rec. 33' mu

1000# Arb. 3395 TD 3403 5" @3396

DD 3411 1000 A B/ 25 goph 4 hr.

2000 A CO to 3411 B/ 11 goph 500 A

S/ 1½ boph 6 hr. 1000 A S/ 3 boph 8 hr

P/ 2½ boph Comp. 118 bopd

J. G. McGEHEE