Barton


DX 78-1

KANSAS

Section 5 Township 20 Range 12W

Well No. #1 Steckel Est.

Company Hilton Drlg.

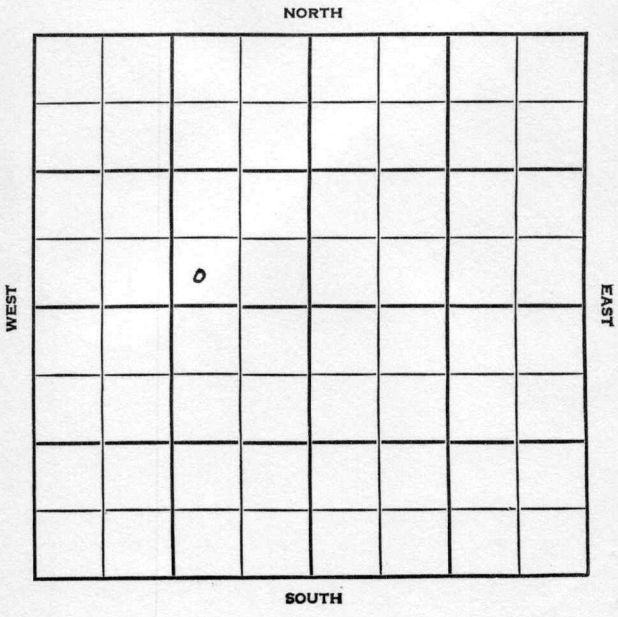

Barton KANSAS

SEC.	TWP.	R.
5	20	12W

WELL NO.

1 Steckel Est. FARM

COMPANY

Hilton Drlg.

CONTRACTOR

Co. Tools
Sunny Valley Pool


_____ Ft. from N. Line

330 Ft. from S. Line

990 Ft. from E. Line

_____ Ft. from W. Line

SW SE NW

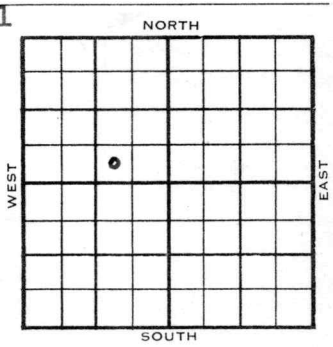

1954	ELEVATION 1824'	REPORT

10/6 Spud 9-30-54
8" @ 134'
Drlg. 1920'

10/13 Spud 9-30-54 - D&A
TD 3467'
8" @ 134'
Heeb 3020', Br. Lime 3137', Lans 3152'
DST 3158-91', opn 1 hr., rec. 10' mud, 1010#
DST 3196-3217', opn 1 hr., rec. 10' mud, 1020#
DST 3219-34', opn 1 hr., rec. 5' mud, 80#
DST 3280-3336', opn 1 hr., rec. 90' WCM, 1140#
Arb. 3398'
DST 3392-3409', opn 2 hrs. 15", rec. 80' HO&GCM, XX 20' O&GCM, 860#
TD 3467'
D&A

ABANDONED

DX-78

FORM 275 FOR SALE BY KANSAS BLUE PRINT CO.


County Barton State Kansas

Sec. 5 (Blk. Twp.) 20 (Sur. Rge.) 12W Map No.

Operator Hilton Drlg.

Well No. 1 Farm Steckel Est.

Elev. Location SW SE NW

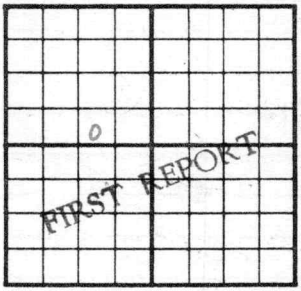

330 Ft. From S Line NW

990 Ft. From E Line Quarter

1st. Report OCT 6 1954

Completion

Remarks

Co. tools

Spudding Date 9-30-54

Drlg. Data Sunny Valley Pool

8" @ 134 drlg. 1920

FABEN GILSTRAP

FORM 275 FOR SALE BY KANSAS BLUE PRINT CO.


County Barton State Kansas

Sec. 5 (Blk. Twp.) 20 (Sur. Rge.) 12W Map No.

Operator Hilton Drlg.

Well No. 1 Farm Steckel Est.

Elev. 1824 Location SW SE NW

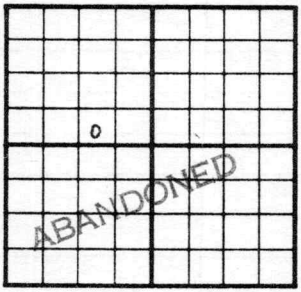

330 Ft. From S Line NW

990 Ft. From E Line Quarter

1st. Report

Completion OCT 13 1954

Remarks Sunny Valley Pool Co. tools

Spudding Date 9-30-54

Drlg. Data D & A TD 3467

8" @ 134 Heeb. 3020 Br. lime 3137 Lans. 3152 DST 3158-91 open 1 hr. Rec. 10' mud 1010# DST 3196-3217 open 1 hr. Rec. 10' mud 1020# DST 3219-34 open 1 hr. Rec. 5' mud 80# DST 3280-3336 open 1 hr. Rec. 90' wcm 1140# Arb. 3398 DST 3392-3409 open 2 hr. 15 min. Rec. 80' ho & gcm 20' o & gcm 860# TD 3467

D & A

FABEN GILSTRAP