
FORM 51 25M 8-50 WESTERN Barton KANSAS

Section 6 Township 20 Range 12 W

Well No. # 1 Birzer

Company Hilton Drlg.

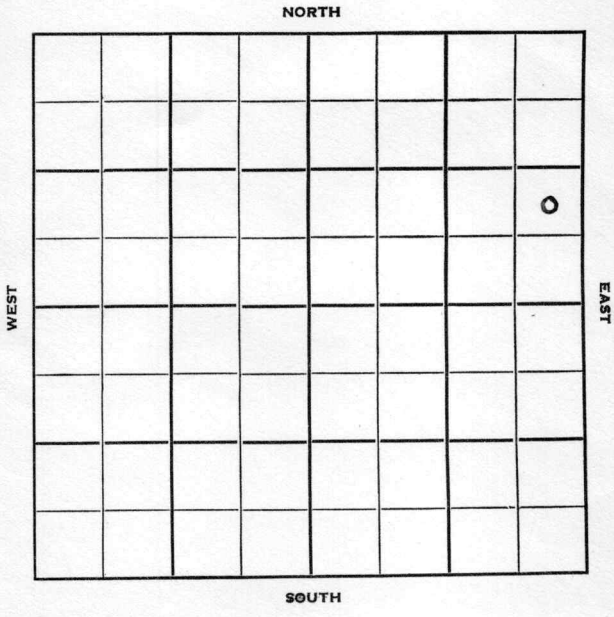

FORM 252-B
10M 8-51 TPCO.

Barton KANSAS

Sec. 6 Twp. 20 R. 12 W

Well No. # 1 Birzer Farm

Hilton Drlg. Company

Hilton Contractor


Ft. from N. Line

990 Ft. from S. Line

330 Ft. from E. Line

Ft. from W. Line

NE SE NE

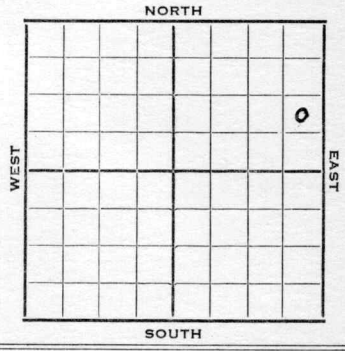

1952	Elev. 1824' REPORT
3/26	Spud 3-24-52 8" @ 157' WOC
4/1	Anhy 648' Drlg. 2905'
4/9	Spud 3-24-52 D & A TD 3432' 8" @ 157' Anhy 648' Heeb 3023' Br. li 3139' Lans. 3154' DST 3171-3202 open ½ hr. rec 25' mud DST 3226-35 open 1 hr. rec 12' SOCM Cong. 3395' TD 3432' D & A

ABANDONED

FORM 275 FOR SALE BY KANSAS BLUE PRINT CO


County Barton State Kansas

Sec. 6 (Blk. Twp.) 20 (Sur. Rge.) 12W Map No.

Operator Hilton Drlg.

Well No. 1 Farm Birzer

Elev. Location NE SE NE

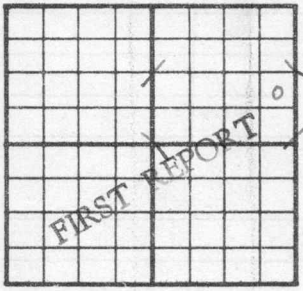

990 Ft. From S Line NE

330 Ft. From E Line Quarter

1st. Report MAR 26 1952

Completion

Remarks

Hilton - Contr.

Spudding Date 3-24-52

Drlg. Data

8" @ 157 W.O.C.

J. G. McGEHEE

FORM 275 FOR SALE BY KANSAS BLUE PRINT CO.


County Barton State Kansas

Sec. 6 (Blk. Twp.) 20 (Sur. Rge.) 12W Map No.

Operator Hilton Drlg.

Well No. 1 Farm Birzer

Elev. 1824 Location NE SE NE

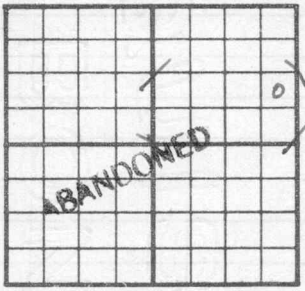

990 Ft. From S Line NE

330 Ft. From E Line Quarter

1st. Report

Completion APR 9 1952

Remarks

Hilton - Contr.

Spudding Date 3-24-52

Drlg. Data D & A TD 3432

8" @ 157 Anhy 648 Heeb. 3023

Br. lime 3139 Lans. 3154 DST 3171-3202

open ½ hr. Rec. 25' mud DST 3226-35

open 1 hr. Rec. 12' soom Cong. 3395

TD 3432 D & A

J. G. McGEHEE