

Section 35 Township 19 Range 3-WWell No. #2 Johnson "B"Company Casebeer
Johnson Pool

0							

NORTH

WEST

EAST

SOUTH

McPherson

KANSAS

Sec. 35 Twp. 19 R. 3W

Well No. #2 Johnson "B" Farm

Casebeer

Company

Johnson Pool

_____ Ft. from N. Line

480'

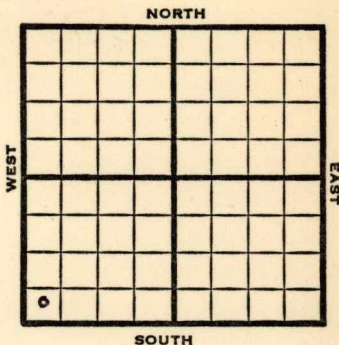
_____ Ft. from S. Line

_____ Ft. from E. Line

360'

_____ Ft. from W. Line

SW/C



1949

Elev. 1501'

REPORT

11/16

Location

11/23

8" @ 206'

Drlg 1529'

11/29

Drlg 2865'

12/7

Miss 2968-

5" @ 2992'

3000 acid

TD 3025'

12/14

Miss 2968'

5" @ 2992'

Acid 3000

Pump 25 oil Pot.

Gr. 36°

TD 3050'

COMPLETED

Kansas

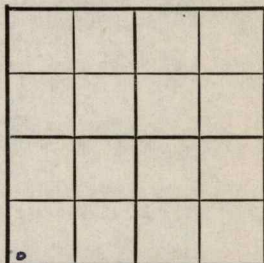
Map No. _____ Sec. 35 Twp. 19 R. 3WWell No. 2 Johnson "B"

Casebeer

Company

Contractor

SW/C

FIRST REPORT
SECTION PLAT

_____ Ft. from N. Line

480 Ft. from S. Line

_____ Ft. from E. Line

360 Ft. from W. Line

McPherson County

Location X

Rig up _____

Drilling and Remarks:

RECORD

Cased _____ in., _____ ft.

Sand _____

Gas _____

Oil _____

Total Depth _____

PRODUCTION

1st 24 hrs. Nat. _____

1st 24 hrs. after shot _____

Gas _____ Cu. Ft.

Dry Hole _____

Abandoned _____

Date

NOV 16 1949

19

S. J. LEWIS

Scout

Kansas

Map No. _____ Sec. 35 Twp. 19 R. 3WWell No. 2 Johnson "B"

Casebeer _____ Company _____

COMPLETE

Contractor _____

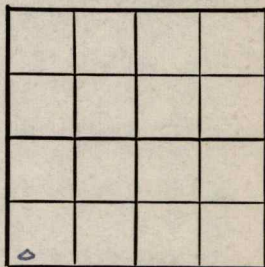
SW/C

E1,1501
SECTION PLAT

_____ Ft. from N. Line

480 Ft. from S. Line

_____ Ft. from E. Line

360 Ft. from W. Line

McPherson County

Location _____

Rig up _____

Drilling and Remarks:

*Miss 2968**5' 02984**3000 acrol**Pump 25 oil 88**36 9/16*

RECORD

Cased _____ in., _____ ft.

Sand _____

Gas _____

Oil _____

Total Depth 3050

PRODUCTION

1st 24 hrs. Nat. _____

1st 24 hrs. after shot _____

Gas _____ Cu. Ft.

Dry Hole _____

Abandoned _____

Date

DEC 14 1949

19

S. J. LEWIS

Scout