


McPherson

Form 51-5M-2-29-34703

Map No. **KANSAS** Sec. 35 Twp. 19 R. 3w

Well No. 3- Johnson Farm
Shell Oil Corp Company

NORTH

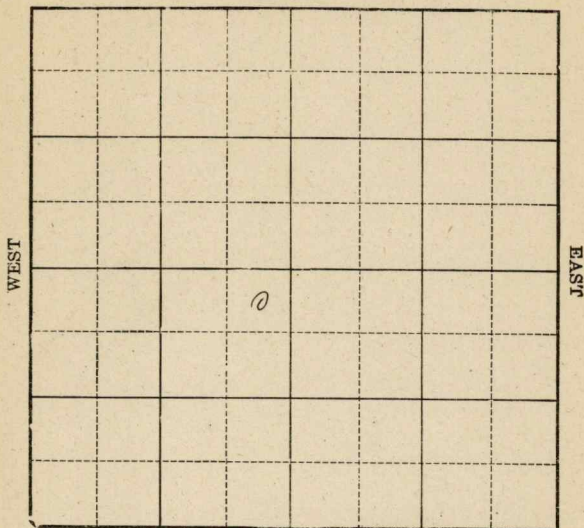

SOUTH

Location

Drilling Remarks

Rig Up

Drilling Remarks

RECORD

Cased in. ft.

Sand

Gas

Oil

Total Depth

PRODUCTION

1st 24 hrs. Nat.

1st 24 hrs. after shot

Gas cu. ft.

Dry Hole

Abandoned

Map No. **KANSAS** Sec. 35 Twp. 19 R. 3^W
Well No. 3 Johnson Farm
Shell Oil Company


330 Ft. from N. Line

 Ft. from S. Line

330 Ft. from E. Line

 Ft. from W. Line

1932

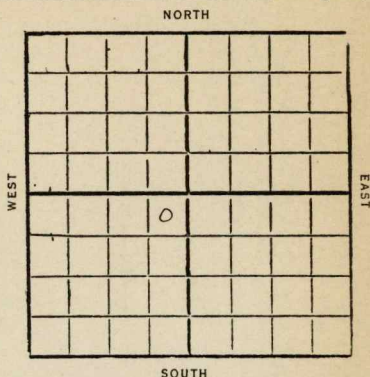

Date

REPORT

6/29	Loc
7/6	
7/13	15"-215 show oil 1485-90 dreg 1915
7/20	Chat 2960-93 Cem 8"-2981 show gas
7/27	TD 29980 Gauge 25,157,000 gas shut in
8/3	TD 3030 Gauge 31 M gas and 23 1/2 bbl oil 24 hr Well run 6"
8/10	TD 3030 6"-3014 flow 92 1/2 bbl 5 hr shut in for pipe line

(over)

8/17- Chat 2960-3032

TD 3032

flow 237½ bbl 24 hr

31 M gas

Comp.

43 KANSAS

Map No. _____ Sec. 35 Twp. 19 R. 3 W

Well No. 3 Johnson

Sheld pet Corp Company

Contractor

FIRST REPORTS

SECTION PLAT

330 Ft. from N. Line

Ft. from S. Line

330 Ft. from E. Line

Ft. from W. Line

	o		

Location ✓

Rig up

Drilling and Remarks:

RECORD

Cased _____ in., _____ ft.

Sand _____

Gas _____

Oil _____

Total Depth _____

PRODUCTION

1st 24 hrs. Nat. _____

1st 24 hrs. after shot _____

Gas _____ Cu. Ft.

Dry Hole _____

Abandoned _____

Date

JUN 29 1932

CHAS. L. SHERWOOD

192

Scout

McPherson

KANSAS

Map No. _____ Sec. 35 Twp. 19 R. 3

Well No. 3 Johnson

Shelley Corp Company

Contractor

COMPLETED

SECTION PLAT

330 Ft. from N. Line

Ft. from S. Line

330 Ft. from E. Line

Ft. from W. Line

Location

Rig up

Drilling and Remarks:

Flow 837 1/2 bbl
24 hours.

RECORD

Cased _____ in., _____ ft.

Sand _____ That 2960-3032

Gas _____

Oil _____

Total Depth 3032

PRODUCTION

1st 24 hrs. Nat. _____

1st 24 hrs. after shot _____

Gas 31 M Cu. Ft.

Dry Hole _____

Abandoned _____

Date

AUG 17 1932

192

CHAS. L. SHERWOOD

Scout