

Section 4 Township 20 Range 18 WWell No. # 1 HarperCompany Morrison Drlg.

NORTH							
WEST							
SOUTH							
EAST							

Sec. 4 Twp. 20 R. 18WWell No. #1 Harper FarmMorrison Drlg. CompanyMorrison Drlg. Contractor

Wildcat.

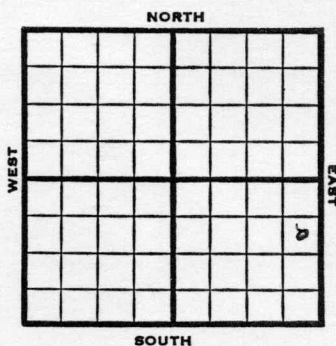
990 Ft. from N. Line

Ft. from S. Line

330

Ft. from E. Line

Ft. from W. Line

SE NE SE
Sinclair - DHM

1953 Elev. 2180' REPORT

7/1 Spud 6-25-53
8" @ 311'
Anhy 1270'
Drlg 2240'

7/9 Lans 3622' B. Penn. sd 4013'
Cong. 4016' Arb. 4020'
DST 4002-4024, 1 $\frac{1}{4}$ hr, 2820' oil, 180'
MCO. 1020# RTD 4024' Rng. pipe.
(Ltr-McGhee)

7/22 5" @ 4020'
CO 4024, 26/4020-23, 10/4019-22,
500A,
S/30 boph
P/12 boph
P/6 boph after 12 hrs.

7/29 Pull tub to W0

8/5 1000 A PB 4020' Sq CO

8/12 Re-sq, CO 4024'

8/19 A-frac, lost load

8/26 DD 4034'

OVER

1953

Information brought forward.

9/2 Spud 6-25-53
8" @ 311'
D & A
TD 4076'
Anhy 1270', Heeb 3574', Lans 3622,
B. Penn Sd. 4013, Cong 4016, Arb
4020
DST 4002-24 opn $1\frac{1}{4}$ hr, rec 2820' oil
180' mco 1020#
TD 4024'
5" @ 4020'
CO to 4024'
20/ 4020-23 10/ 4019-22 500 A
S/ 30 boph P/ 12 boph P/ 6 boph
1000 A PB 4020 CO to 4024 A-frac
DD 4034 1000 A DD 4076
D & A

ABANDONED

County **Pawnee** State **Kansas**

Sec. 4 (Blk. 20 (Sur. 18W Map No.

Operator Morrison Drlg.

Well No. 1 Farm Harper

Elev.	Location	SE	NE	SE
-------	----------	----	----	----


990 Ft. From N Line SE

330 Ft. From E Line Quarter

1st. Report JUL 1 1953

Completion

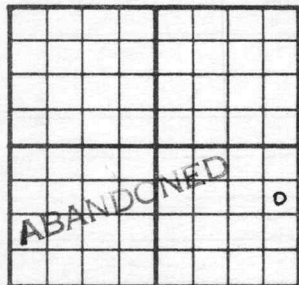
Remarks Sinclair - DEM

Morrison Drlg. - Contr.

Spudding Date 6-25-53

Drlg. Data Wildcat

8" @ 311 Anhy 1270 drlg. 2240

County Pawnee State KansasSec. 4 (Blk.) 20 (Sur.) 18W Map No.
(Twp.) (Rge.)Operator Morrison Drlg.Well No. 1 Farm HarperElev. 2180 Location SE NE SE990Ft. From N Line SE330Ft. From E Line Quarter1st. Report Completion SEP 2 1953Remarks WildcatMorrison Drlg. - Contr.Spudding Date 6-25-53Drlg. Data D & A TD 40768" @ 311 Anhy 1270 Heeb. 3574Lans. 3622 B. ~~Pann~~ sd. 4013 Cong. 4016Arb. 4020 DST 4002-24 open $1\frac{1}{4}$ hr.Rec. 2820' oil 180' mco 1020#TD 4024 5" @ 4020 CO to 402420/ 4020-23 10/ 4019-22 500 AS/ 30 boph P/ 12 boph P/ 6 boph1000 A PB 4020 CO to 4024 A-fracDD 4034 1000 A DD 4076D & A

J. G. McGEHEE