


Map No. **KANSAS** Sec. 35 Twp. 19 R. 3<sup>d</sup>  
Well No. 5-Johnson Farm \_\_\_\_\_  
Shell Oil Company

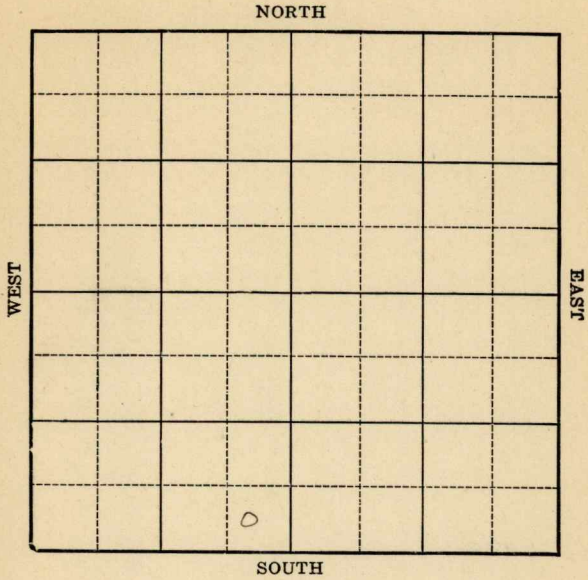

Location \_\_\_\_\_  
Drilling Remarks \_\_\_\_\_  
\_\_\_\_\_  
\_\_\_\_\_  
Rig Up \_\_\_\_\_  
Drilling Remarks \_\_\_\_\_  
\_\_\_\_\_  
\_\_\_\_\_  
**RECORD**

Cased \_\_\_\_\_ in. \_\_\_\_\_ ft.  
Sand \_\_\_\_\_  
Gas \_\_\_\_\_  
Oil \_\_\_\_\_  
Total Depth \_\_\_\_\_

**PRODUCTION**

1st 24 hrs. Nat. \_\_\_\_\_  
1st 24 hrs. after shot \_\_\_\_\_  
Gas \_\_\_\_\_ cu. ft.  
Dry Hole \_\_\_\_\_  
Abandoned \_\_\_\_\_

Map No. **KANSAS** Sec. 35 Twp. 19 R. 3W


Well No. 5 Johnson Farm  
Shell Oil Company

         Ft. from N. Line

330 Ft. from S. Line.

330 Ft. from E. Line

         Ft. from W. Line

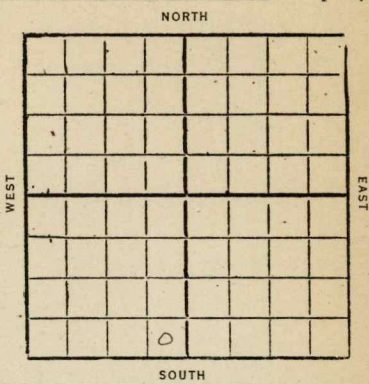

1932

Date	REPORT
10/26	Loc
11/2	Cem 15"-220'
11/9	SD 1977'
11/16	dreg 2905'
11/23	Chat 2966
	Cem 8"-3009 Rust
11/30	Correction 3009=3007
	900 ft oil in 1.5 hr
	Increase oil 3009-10'
	1800 ft oil
	TD 3043 Testing
12/7	Cased 8"-3009
	Chat 2964-3037
	TD 3037
	swab 190 bbl 8 hr
	1/2 M gas
	Comp.

*McPherson*

43 **KANSAS** Map No. Sec. 35 Twp. 19 R. 3 <sup>W</sup>

Well No. 5 *Johnson*

*Shell Oil Corp* Company

Contractor

**FIRST REPORTS**

**SECTION PLAT**

..... Ft. from N. Line  
330 Ft. from S. Line  
330 Ft. from E. Line  
..... Ft. from W. Line


Location  .....  
Rig up .....  
Drilling and Remarks:

**RECORD**

Cased ..... in., ..... ft.  
Sand .....  
Gas .....  
Oil .....  
Total Depth .....

**PRODUCTION**

1st 24 hrs. Nat. ....  
1st 24 hrs. after shot .....  
Gas ..... Cu. Ft.  
Dry Hole .....  
Abandoned .....

Date

OCT 26 1932

192 **CHAS. L. SHERWOOD** Scout

McPherson

43

KANSAS

Map No. Sec. 35 Twp. 19 R. 3<sup>W</sup>

Well No. 5 Johnson

Shell per G

Company

Contractor

COMPLETED

SECTION PLAT


Ft. from N. Line

330 Ft. from S. Line

330 Ft. from E. Line

Ft. from W. Line

Location

Rig up

Drilling and Remarks:

Swab 190 lbs  
8 hours.

RECORD

Cased 8 in., 3009 ft.

Sand Chat 2964-3037

Gas

Oil

Total Depth 3037

PRODUCTION

1st 24 hrs. Nat.

1st 24 hrs. after shot

Gas 1/2 AT Cu. Ft.

Dry Hole

Abandoned

Date

DEC 7 1932

CHAS. L. SHERWOOD

192

Scout