

Section 11 Township 20 Range 18WWell No. #1 BlackCompany Imperial Drlg.

NORTH

0							

SOUTH

WEST

EAST

SEC.	TWP.	R.
11	20	18W ✓

WELL NO.

1 Black

FARM

COMPANY

Imperial Drlg.

CONTRACTOR

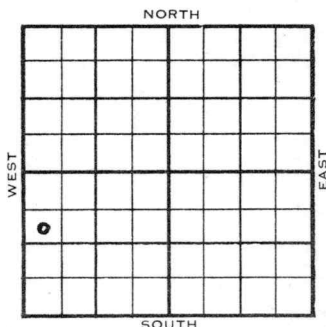
Imperial
Wildcat

990 Ft. from N. Line

Ft. from S. Line

Ft. from E. Line

330 Ft. from W. Line



SW NW SW

Morrison - DHM

	ELEVATION	REPORT
1954	2154'	

4/14

8" @ 346'

Drlg. 2030'

4/28

Spud 4-10-54

D & A

TD 4064'

8" @ 346'

Anhy 1230', Heeb 3539' Lans 3591'

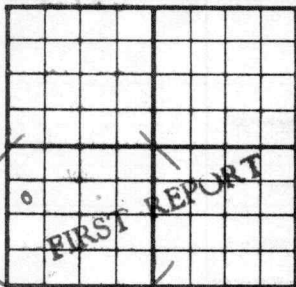
cong 4004', Arb 4024'

DST 4025'-30' opn 1 hr, rec 3' Mud
0#DST 4032'-42' opn 1 hr, rec 20' Mud
834#DST 4048'-64' opn 3/4 hr, rec 15' Mud
470#

TD 4064'

D & A

ABANDONED

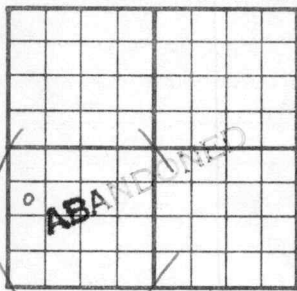
County Pawnee State KansasSec. 11 (Blk.) 20 (Sur.) 18W Map No.Operator Imperial Drlg.Well No. 1 Farm BlackElev. Location SW NW SW990 Ft. From N Line SW330 Ft. From W Line Quarter1st. Report APR 14 1954

Completion

Remarks Morrison - DHM
Imperial - Contr.

Spudding Date

Drlg. Data Wildcat8" @ 346 drlg. 2030

County Pawnee State KansasSec. 11 (Blk.
Twp.) 20 (Sur.
Rge.) 18W Map No.Operator Imperial Drlg.Well No. 1 Farm BlackElev. 2154 Location SW NW SW990 Ft. From N Line SW330 Ft. From W Line Quarter

1st. Report

Completion APR 28 1954Remarks WildcatImperial - Contr.Spudding Date 4-10-54Drlg. Data D & A TD 40648" @ 346 Anhy 1230 Heeb. 3539Lans. 3591 Cong. 4004 Arb. 4024DST 4025-30 open 1 hr. Rec. 3' mud0# DST 4032-42 open 1 hr. Rec. 20' mud834# DST 4048-64 open 3/4 hr. Rec.15' mud 470# TD 4064D & A

J. G. McGEHEE