


Section 19 Township 20 Range 18W
Well No. 1 Fox
Company Musgrove Petr.

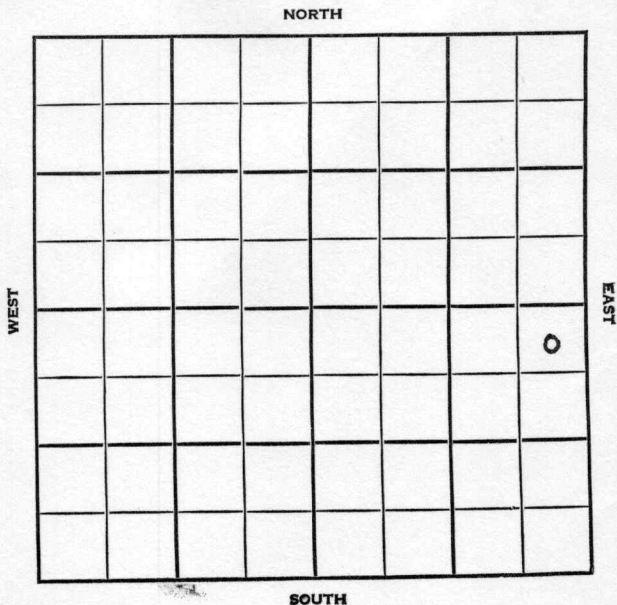

Pawnee KANSAS

SEC.	TWP.	R.
19	20	18W

WELL NO.

1 Fox

FARM

COMPANY

Musgrove Petr.

CONTRACTOR

Co. Tools


Wildcat

330 Ft. from N. Line

Ft. from S. Line

330 Ft. from E. Line

Ft. from W. Line

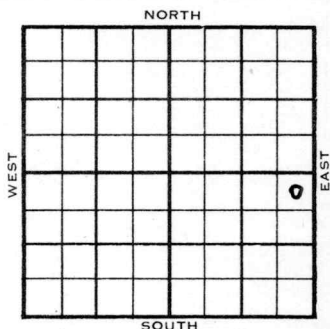

NE NE SE


Sunray - DHM

	ELEVATION	REPORT
1954	2200'	

8/25 Spud 8-24-54
8" @ 336', WOC

9/15 Spud 8-24-54 - D&A
TD 4163'
8" @ 336'
Anhy 1304', Heeb 3625', Lans
3674'
TD 4215'
Schl Tops: Tor 3642', B KC
3966', Cong 4107', Arb. 4163'
D&A


ABANDONED

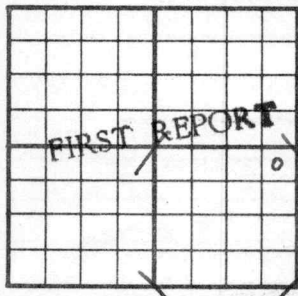County Pawnee State KansasSec. 19 (Blk.) 20 (Sur.) 18W Map No.Operator Musgrove Pet.Well No. 1 Farm FoxElev. Location NE NE SE330 Ft. From N Line SE330 Ft. From E Line Quarter1st. Report AUG 25 1954

Completion

Remarks Sunray - DHMCo. toolsSpudding Date 8-24-54Drlg. Data Wildcat8" 336 WOC

FABEN GILSTRAP

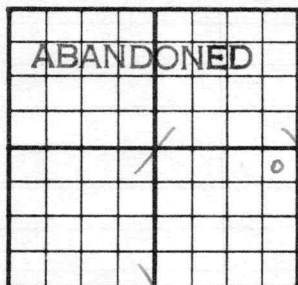County Pawnee State KansasSec. 19 (Blk.
Twp.) 20 (Sur.
Rge.) 18W Map No.Operator Musgrove Pet.Well No. 1 Farm FoxElev. 2200 Location NE NE SE330 Ft. From N Line SE330 Ft. From E Line Quarter

1st. Report

Completion SEP 15 1954Remarks WildcatCo. toolsSpudding Date 8-24-54Drlg. Data D & A TD 41638" @ 336 Anhy 1304 Heeb. 3625Lans. 3674 TD 4215SCHLUMBERGER TOPSTor. 3642 B KC 3966 Cong. 4107Arb. 4163D & A

FABEN GILSTRAP