


Section 29 Township 20 Range 18-W

Well No. #1 Peters "B"

Company Cities Service Oil
Wildcat

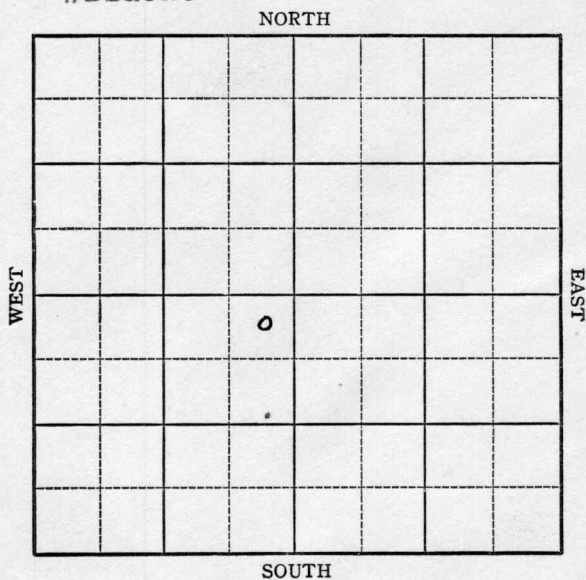

KANSAS

Pawnee

Sec. 29 Twp. 20 R. 18-W

Well No. #1 Peters "B" Farm

Cities Service Oil Company
(Wildcat)

330 Ft. from N. Line


Ft. from S. Line

330

Ft. from E. Line

Ft. from W. Line

Elev. 2134

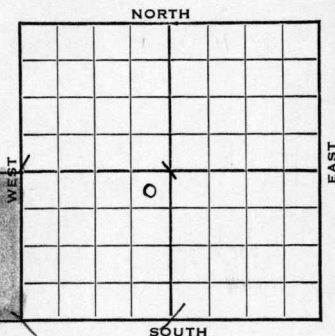

1942

REPORT

8/27
9/2

Location
12" - 203
Drlg. 790

~~8/27~~
9/9

~~K~~
8" - 1169 TD 1185 WOC

9/16

Drlg. 3270

9/23

Lans. 3640
Arb. 4021
No shows
T.D. 4090

*This Arbuckle point
was checked with
the Gulf by:*

ABANDONED

*Oscar Hatcher
3/12/43.*


*4021
2134
1887*

Pawnee

Map No. 81 Sec. 29 Twp. 20 R. 18WWell No. 1 Peters "B"Cities Service Oil CompanyFIRST REPORT Contractor

NE SW

SECTION PLAT

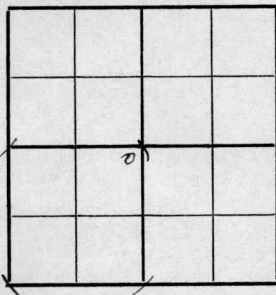330 Ft. from N. Line

Ft. from S. Line

330 Ft. from E. Line

Ft. from W. Line

WILDCAT

RECORD

Location XXX

Cased _____ in., _____ ft.

Sand _____

Gas _____

Oil _____

Total Depth _____

Rig up _____

Drilling and Remarks:

PRODUCTION

1st 24 hrs. Nat. _____

1st 24 hrs. after shot _____

Gas _____ Cu. Ft.

Dry Hole _____

Abandoned _____

Date

AUG 27 1942

19

S. J. LEWIS

Scout

KANSAS

Pawnee

Map No. 81 Sec. 29 Twp. 20 R. 18WWell No. 1 Peters "B"Cities Service Oil CompanyABANDONED Contractor

NE SW

SECTION PLAT

330 Ft. from N. Line

Ft. from S. Line

330 Ft. from E. Line

Ft. from W. Line

WILDCAT

RECORD

Location _____

Cased _____ in., _____ ft.

Rig up _____

Sand _____

Drilling and Remarks:

Gas _____

Oil _____

Total Depth 4090Lane 3640Cr 4021Noshovok

PRODUCTION

1st 24 hrs. Nat. _____

1st 24 hrs. after shot _____

Gas _____ Cu. Ft.

Dry Hole _____

Abandoned _____

Date

SEP 23 1942 19S. J. LEWIS Scout