


Section 2 Township 20 Range 19WWell No. #1 FrunzCompany Cities Service & Sun

NORTH

WEST

EAST

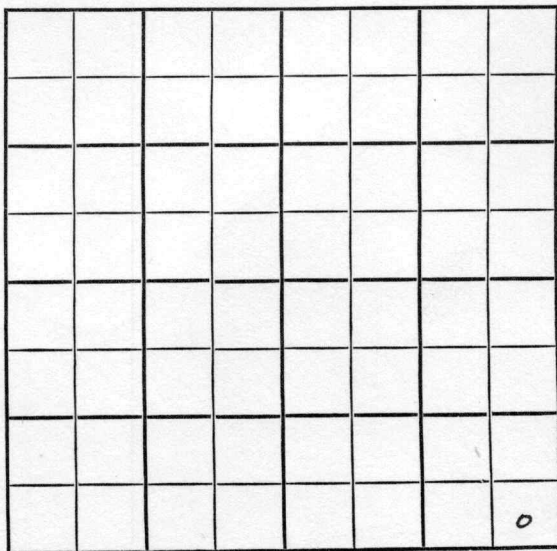

SOUTH

Pawnee KANSAS

SEC.	TWP.	R.
2	20	19W

WELL NO.

1 Frunz

FARM

COMPANY

Cities Service & Sun

CONTRACTOR


Lohman & Johnson

_____ Ft. from N. Line

330 _____ Ft. from S. Line

330 _____ Ft. from E. Line

_____ Ft. from W. Line

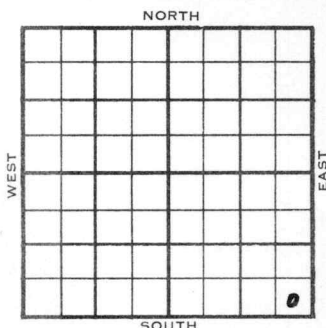

SE SE SE

	ELEVATION	REPORT
1955	2208'	
1/5	Location	
2/9	S ₁ pud 1-22-55 - D&A	
	TD 4260'	
	8" @ 400'	
	Top. 3373', Heeb. 3635', Dodge 3655',	
	Lans. 3687', B KC 3992', B. Penn. 4100'	
	DST 4102-08', opn 1 hr., rec. 2210'	
	sw, 1020#	
	DST 4109-16', opn 1 hr., rec. 2250' SW	
	1152#	
	Cong. 4121'	
	DST 4122-39', opn 1/2 hrs., rec. 30' mud	
	O#	
	EroArb. 4186', Arb. 4194'	
	TD 4260'	
	D&A	
	ABANDONED	

County Pawnee State KansasSec. 2 (Blk.) 20 (Sur.) 19W Map No.Operator Cities Service & SunWell No. 1 Farm FrunzElev. Location SE SE SE

330 Ft. From S Line SE330 Ft. From E Line Quarter1st. Report IAN 5 1955

Completion

Remarks


Spudding Date

Drlg. Data

Location

FABEN GILSTRAP

County Pawnee State Kansas
 Sec. 2 (Blk. 20 (Sur. 19W Map No.
 (Twp. (Rge.
 Operator Cities Service & Sun Oil
 Well No. 1 Farm Frunz
 Elev. 2208 Location SE SE SE

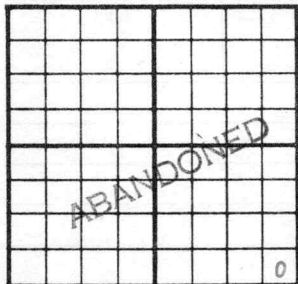

330 Ft. From S Line SE

330 Ft. From E Line Quarter

1st. Report

Completion FEB 9 1955

Remarks

Lohman & Johnson - Contr

Spudding Date 1-22-55

Drlg. Data D & A TD 4260

8" @ 400 Top. 3373 Heeb. 3635

Dodge 3655 Lans. 3687 B KC 3992

B. Penn. 4100 DST 4102-08 open 1 hr.

Rec. 2210' sw 1020# DST 4109-16

open 1 hr. Rec. 2250' sw 1152#

Cong. 4121 DST 4122-39 open $\frac{1}{2}$ hr.

Rec. 30' mud 0# EroArb. 4186

Arb. 4194 TD 4260

D & A

FABEN GILSTRAP