Pawnee


KANSAS

FORM 51

Section 4 Township 20 Range 19W

Well No. 1 Kitch

Company M.B. Armer

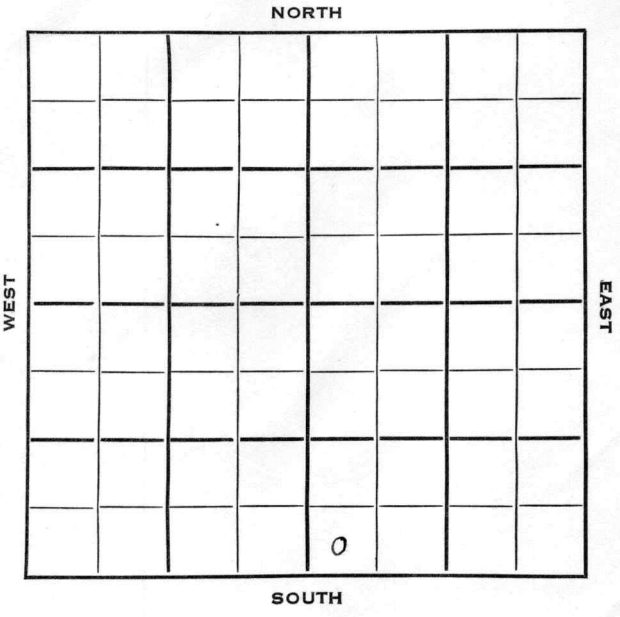

FORM 252-B
10M 8-51 TPCO.

Pawnee KANSAS ✓

Sec. 4 Twp. 20 R. 19 W

Well No. # 1 Kitch Farm

M. B. Armer Company

Contractor


Ft. from N. Line

330 Ft. from S. Line

Ft. from E. Line

330 Ft. from W. Line

SW SW SE

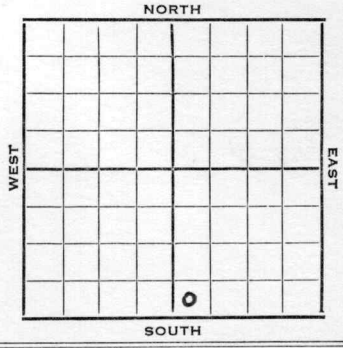

1953 Elev. 2257' REPORT

4/8 Location
4/16 "
4/23 "
4/30 "
5/7 8" @ 139'
5/20 Spud 5-4-53
D&A
TD 4308
8" @ 139
Anhy 1405, Heeb 3738, Lans 3782,
Cong 4248
DST 4247-55, opn 1 hr., rec. 1740' sw
1220#
TD 4308
D&A

ABANDONED

FORM 275 FOR SALE BY KANSAS BLUE PRINT CO.


County Pawnee State Kansas

Sec. 4 (Blk. Twp.) 20 (Sur. Rge.) 19W Map No.

Operator M. B. Armer

Well No. 1 Farm Kitch

Elev. Location SW SW SE

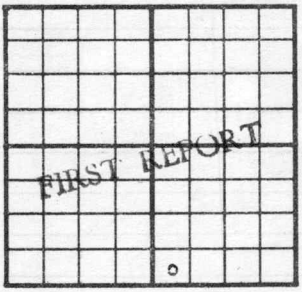

330 Ft. From S Line SE

330 Ft. From W Line Quarter

1st. Report APR 8 1953

Completion

Remarks

Spudding Date

Drlg. Data

Location

J. G. McGEHEE

FORM 275 FOR SALE BY KANSAS BLUE PRINT CO.

County Pawnee State Kansas

Sec. 4 (Blk. Twp.) 20 (Sur. Rge.) 19W Map No.

Operator M. B. Armer

Well No. 1 Farm Kitch

Elev. 2257 Location SW SW SE



330 Ft. From S Line SE

330 Ft. From W Line Quarter

1st. Report

Completion MAY 2 0 1953

Remarks

Spudding Date 5-4-53

Drlg. Data D & A TD 4308

8" @ 139 Anhy 1405 Heeb. 3738

Lans. 3782 Cong. 4248 DST 4247-55

open 1 hr. Rec. 1740' sw 1220# TD 4308

D & A

J. G. McGEHEE