
DX 78-1

Pawnee KANSAS

Section 4 Township 20 Range 19W

Well No. 1 Kitch

Company Musgrove Petr.

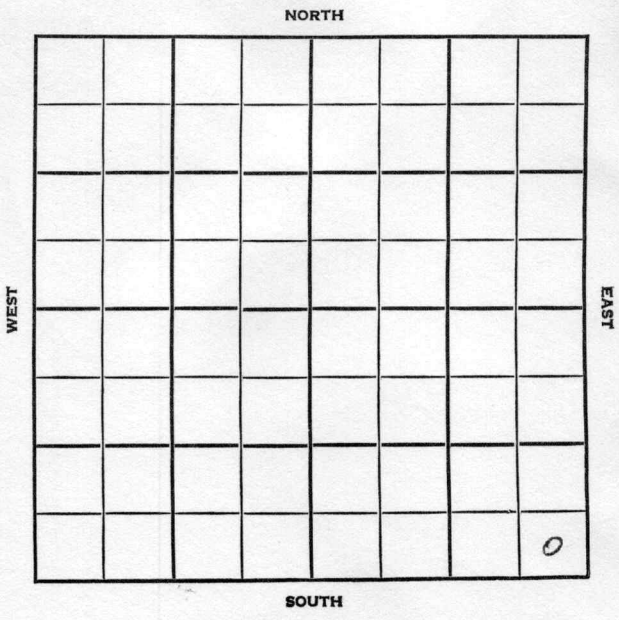

Pawnee KANSAS

SEC.	TWP.	R.
4	20	19W


WELL NO.
1 Kitch
FARM

COMPANY
Musgrove Petr.

CONTRACTOR
Co. Tools
Oro Ext.

_____ Ft. from N. Line
330 Ft. from S. Line
330 Ft. from E. Line
_____ Ft. from W. Line

SE SE SE

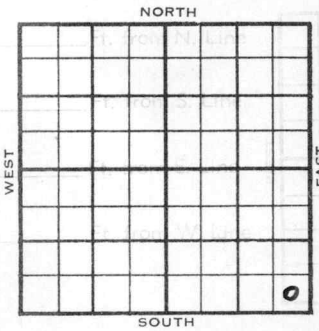

1955	ELEVATION 2225'	REPORT
3/2	Spud 2-25-55 8" @ 360' Drlg. 2250'	
3/16	Spud 2-25-55 D&A TD 4360 8" @ 360 Heeb 3712, Tor 3732, Lans 3758, B KC 4088, Cong, 4204, Cong Sd 4218, DST 4201-25, open 25 min. Rec 210' 1220# Miss 4336 TD 4360 D&A	

ABANDONED

DX-78

DX-78

FORM 275 FOR SALE BY KANSAS BLUE PRINT CO.


County Pawnee State Kansas

Sec. 4 (Blk. Twp.) 20 (Sur. Rge.) 19W Map No.

Operator Musgrove Pet.

Well No. 1 Farm Kitch

Elev. Location SE SE SE

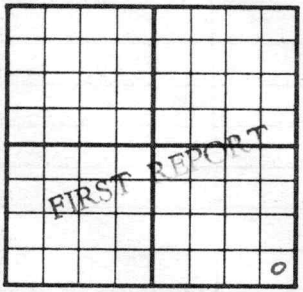

330 Ft. From S Line SE

330 Ft. From E Line Quarter

1st. Report MAR 2 1955

Completion

Remarks

Co. tools

Spudding Date 2-25-55

Drlg. Data Oro Ext.

8" @ 360 drlg. 2250

FABEN GILSTRAP

FORM 275 FOR SALE BY KANSAS BLUE PRINT CO.

County Pawnee State Kansas

Sec. 4 (Blk. Twp.) 20 (Sur. Rge.) 19W Map No.

Operator Musgrove Pet.

Well No. 1 Farm Kitch

Elev. 2225 Location SE SE SE



330 Ft. From S Line SE

330 Ft. From E Line Quarter

1st. Report

Completion MAR 1 6 1955

Remarks Oro Ext. Pool Co. tools

Spudding Date 2-25-55

Drlg. Data D & A TD 4360

8" @ 360 Heeb. 3712 Tor. 3732

Lans. 3758 B KC 4088 Cong. 4204

Cong. sd. 4218 DST 4201-25 open 25 min.

Rec. 210' mw 1220# Miss. 4336

TD 4360

D & A

FABEN GILSTRAP