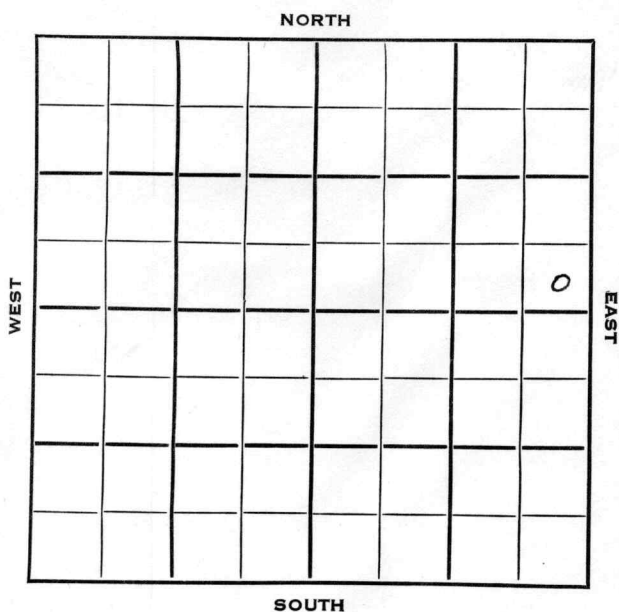


Pawnee

Section 9 Township 20 Range 19W ^{KANSAS}Well No. 1 EllisCompany M. B. Armer

Pawnee

KANSAS

Sec. 9 Twp. 20 R. 19WWell No. #1 Ellis Farm

M. B. Armer

Company

Prime Drlg.

Contractor

Wild cat

Ft. from N. Line

330


Ft. from S. Line

330

Ft. from E. Line

Ft. from W. Line

SE SE NE

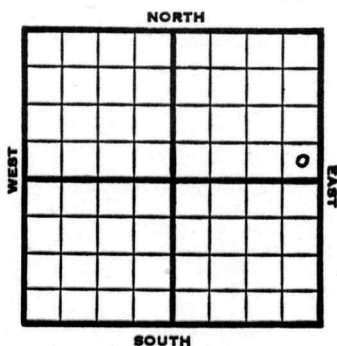

1952 Elev. 2247' REPORT

12/17 Spud 12-11-52

8" @ 245'

Anhy 1405'

Drlg. 1931'

12/25 Drlg 1931

1/1 Lans 3723 Marm 4061 Cong 4200 DST 4200-
4220 1 hr. 1500' clean oil 185' MCO
1565#

1/8 RTD 4220 5" @ 4220

1/22 DD 4224 TD
36/4204-20, FU 3200' oil 12 hrs

1/29 NR

2/5 P/17 BOPH 17 hrs.

2/12 NR

2/19 "

2/26 "

OVER

#1 Ellis

1953

3.4

Spud 12-11-52

OilWell

TD 4224

8" @ 245

Anhy 1405, Heeb 3672, Lans

3723, Marm 4061, Cong 4200

DST 4200-20, opn 1 hr., rec.

1500' cleannoil, 185' cmo

1565#

TD 4220

5" @ 4220

DD 4224

36/4204-20, FU 3200' oil 12 hrs.

P/16 boph 17 hrs.

Comp. 651 bopd

COMPLETED

County **Pawnee** State **Kansas**
Sec. **9** (Blk. Twp.) **20** (Sur. Rge.) **19W** Map No.

Operator **M. B. Armer**

Well No. **1** Farm **Ellis**

Elev. **2247** Location **SE SE NE**

FIRST REPORT

330 Ft. From **S** Line **NE**

330 Ft. From **E** Line Quarter

1st. Report **DEC 17 1952**

Completion

Remarks

Prime Drlg. - Contr.

Spudding Date **12-11-52**

Drlg. Data **Wildcat**


8" @ 245 Anhy 1405 drlg. 1931

County Pawnee State Kansas
 Sec. 9 (Blk.) 20 (Sur.) 19W Map No.

Operator M. B. Armer

Well No. 1 Farm Ellis

Elev. 2247 Location SE SE NE

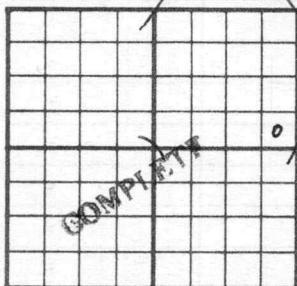

330 Ft. From S Line NE

330 Ft. From E Line Quarter

1st. Report

Completion MAR 4 1953

Remarks Wildcat

Prime Drlg. - Contr.

Spudding Date 12-11-52

Drlg. Data Oil well TD 4224

8" @ 245 Anhy 1405 Heeb. 3672

Lans. 3723 Marm. 4061 Cong. 4200

DST 4200-20 open 1 hr. Rec. 1500' clean

oil 185' cmo 1565# TD 4220

5" @ 4220 DD 4224 36/ 4204-20

FU 3200' oil 12 hr. P/ 16 boph. 17 hr.

Comp. 651 bopd