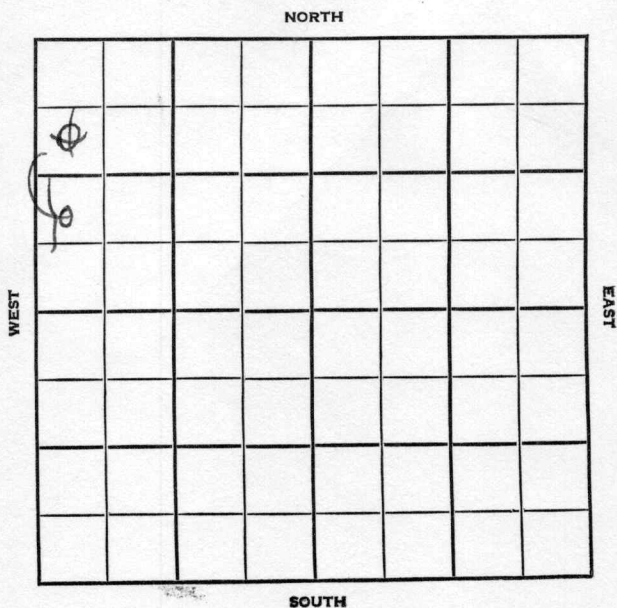


Section 10 Township 20 Range 19 WWell No. # 5 HagermanCompany M. B. Armer

Pawnee KANSAS

SEC.	TWP.	R.
10	20	19W

WELL NO.

5 Hagerman

FARM

COMPANY

M. B. Armer

CONTRACTOR

Oro Pool

~~990~~ Ft. from N. Line


1200 Ft. from S. Line

250 Ft. from E. Line

~~330~~ Ft. from W. Line

~~SW NW NW~~

NW SW NW

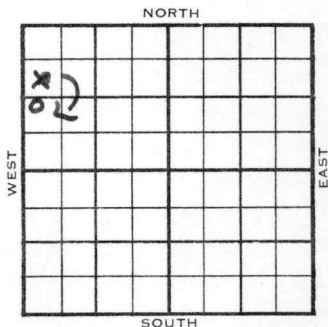

ELEVATION

REPORT

1955

3/16

MIR

County **Paynee** State **Kansas**

Sec. 10 (Blk.) 20 (Sur.) 19W Map No.

Operator M. B. Armer

Well No. 5 Farm Hagerman

Elev.	Location	SW	NW	NE
-------	----------	----	----	----

990 Ft. From N Line NW

330 Ft. From W Line Quarter

1st. Report MAR 16 1955

Completion

Remarks

Spudding Date _____

Drlg. Data Oro Pool

M T R

FABEN GILSTRAP

SCOUT TICKET

DX-201

Kansas

SEC.

10

TWP.

20

R.

19W

WELL NO.

5 Hagerman

FARM

COMPANY

M. B. Armer

CONTRACTOR

CORRECTION

NW SW NW

____ FT. FROM N. LINE

1200

____ FT. FROM S. LINE

____ FT. FORM E. LINE

250

____ FT. FROM W. LINE

NORTH

WEST

EAST

SOUTH

Pawnee County

☐

LOCATION

☐

RIG UP

DRILLING AND REMARKS:

Reported

SNNW SW

RECORD

CASED IN., FT.

SAND

GAS

OIL

TOTAL DEPTH

PRODUCTION

1ST 24 HRS. NAT.

1ST 24 HRS. AFTER SHOT

GAS CU. FT.

DRY HOLE

ABANDONED

DATE

SCOUT

MAR 30 1955

FABEN GILSTRAP