

Pawnee

KANSAS

Section 6 Township 20 Range 19 W

Well No. #1 Schneider

Company Frontier Oil

NORTH

WEST

EAST

SOUTH

Pawnee

KANSAS

SEC. 6-	TWP. 20	R. 19W
------------	------------	-----------

WELL NO. #1 Schneider

COMPANY Frontier Oil

CONTRACTOR Keifer & Kraus


WILDCAT

Ft. from N. Line

Ft. from S. Line

Ft. from E. Line

Ft. from W. Line

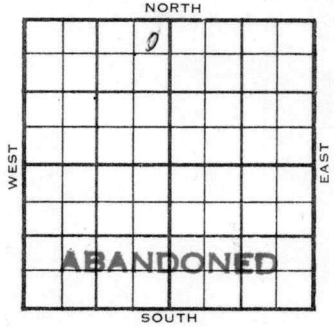

NE NE NW

1956	ELEVATION	REPORT
------	-----------	--------

2-8	Location
-----	----------

County Pawnee Elev. _____
Sec. 6 Twp. 20 Rge. 19W
Company Frontier Oil
Farm Name Schneider No. 1

TOPS	DEPTH	LOG	DATUM
Anh.			
Tr.			
H.			
Tr.			
Dg.			
B.L.			
L.			
K.C.			
B.K.C.			
Ce.			
C.			
M.			
M.			
K.			
Mz.			
Mq.			
V.			
S.			
S.			
A.			
R.			
Pf.			
G.			
T.D.			

Loc. in Sec. NE NE NW
Geol. _____
Contr. Keifer & Knas
Pool Wildcat

FIRST REPORT
FEB 8 '56

Date Comm. _____
Location _____

Co.
No.
Sec.
T.
R.

County Paynee Elev. 2251
 Sec. 6 Twp. 20 Rge. 19W
 Company Frontier Oil
 Farm Name Schneider No. 1

TOPS	DEPTH	LOG	DATUM	Loc. in Sec.
Ank.	1300			NE NE NW
Tp.				
H. 3746	3770	3744		
Tr.				
Dg.				
Bl.				
L. 3789	3770	3789	1538	Geol.
K.C.				
R.K.C. 4120	4100		1869	Contr.
Gr. Marm	4100	4131	1880	Keifer & Knolls
C. 69	4100	4238	1987	
M. 69	4272	4270	2019	Pool
M. 152	4337	4360	2109	Wildcat
K.	4470	4491	2240	
Mr.				
Ma.	4544	4540	2289	
V.		4612	2361	
S.				
S.	4627	4628	2377	
A.				
R.				
PE.				
G.				
SB	4680			

Date Comm. shen WHM
 Location FEB 15 '56 2-13-56 878
207/200 FEB 22 '56 1P 3265
FEB 29 '56 DST 3836-79 one lbm
rec 9 to S 2" rec 2440' SW
FP 200-1150 BHP 1300/20
DST 4157-83 one 45" rec 10' Md
all press 0 4157-4220 lbm
rec 15' Md FP 0 BHP 490/20
MAR 7 '56 DST 4225-65 30" rec

10' ϕ Md BHP 0130" DST
4272-4300 1hr rec 2340'
SW BHP 12501 Rng Log

NEA

Hold

R. G.

MAR 19 1956